

BOLIVAR
C 69
4-2-74

MISSISSIPPI
 BOARD OF WATER COMMISSIONERS
 416 North State Street
 Jackson, Mississippi 39201

CODED

WATER WELL DRILLERS LOG

4/2 date well completed
 1974 *Dickson & Supply Co* firm name
Bolivar county well located


LANDOWNER:	description of formations encountered	from	to
<i>Smalley Seed Co</i> <i>Sumner, Miss.</i> (mailing address)			
	<i>Table sand</i>	<i>16</i>	<i>40</i>
	<i>Sand & gravel</i>	<i>40</i>	<i>113</i>

WELL LOCATION:
 sec *24* T *24* N R *7* E
3 1/2 miles *East* of *Sumner*
 (distance) (direction) (nearest town)

WELL PURPOSE: *Irrigation*
 (home, irrigation, municipal, industrial)

- WELL COMPLETION DATA:
- (1) diameter (inches) 16
 - (2) total depth (feet) 113
 - (3) static water level (feet) 18 below above top of ground.
 - (4) casing Steel (material) (depth) _____
 (size) if telescope see back.
 - (5) screen 40ft (length) (depth to top) _____
16 (size) Steel (material)
 - (6) pump 40 (HP) 2000 (yield gpm)
Diavel (type power)
 - (7) electric log No (yes or no)
 - (organization running log)
 - (8) how well bottom plugged Steel Plate

CODED

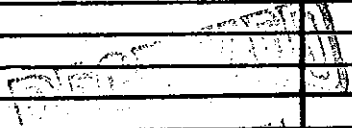

APR 22 1974

MISS. BD. OF WATER COMM

DRILLERS REMARKS: