

**BOLIVAR** MISSISSIPPI BOARD OF WATER COMMISSIONERS

**CODED WATER WELL DRILLERS LOG**

11-13-64

CODED

11/23/64  
J@1903

Date: Nov. 13, 1964, Driller: Layne-Central Company County Bolivar

(Name)

(1) Owner of Land: W. A. Welshans, Jr.  
(Name)  
Rosedale, Mississippi  
(Address)

(2) Location: 1/4, 1/4, Sec. 2 T24N R7W  
7 1/4 miles north of Perthshire  
(distance) (direction) (Nearest Town)

(3) Topography: flat  
(Hilly) (Flat) (Level)

(4) Purpose of Well: domestic  
(Domestic Irrigation  
Municipal, Industrial, Other)

Description & Color of Materials Sand, Clay, Red Clay, Shell, etc.	Thick- ness Feet	Depth Feet
Clay	19	19
Fine mulky sand	19	38
Sand	12	50
Coarse sand	26	76
Coarse sand & pea gravel	19	95
Coarse sand & gravel	39	134
Coarse sand	7	141
Sand & cemented gravel	3	144
Coarse sand & gravel	26	170
Sand	131	301
Clay	14	315
Sand	53	368
Sand strks. lignite	8	376
Sand	90	466

Information upon completion of well:

(1) Diameter 4x3 inches.

(2) Total Depth 463' 8" feet.

(3) Water Level 20' feet below top of ground.

(4) Cased to 29 1/4' Size 3"  
419' 2" Top of screen

(5) Screen: Size 3" Length 30 1/4"  
Tail pipe 3" 14' 2"


(6) Were any formations sealed against pollution?  
yes yes, no no.

If YES depth of formation Packer above  
the screen.

Why \_\_\_\_\_

Drillers Remarks: \_\_\_\_\_

CODED

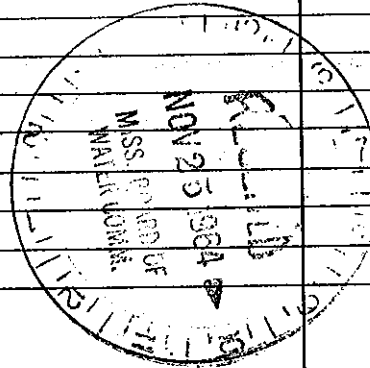

(Use Back Side)

Well No.

ail this copy to Board of Water Commissioners 429 Miss. St. Jackson, Miss