

**BOLIVAR** MISSISSIPPI BOARD OF WATER COMMISSIONERS


**C** <sup>75</sup> **CODED** WATER WELL DRILLERS LOG **CODED** 136  
**10-7-62**

Date: October 7, 1962, Driller: Layne-Central Company County Bolivar

(Name)

	Description & Color of Materials Sand, Clay, Red Clay, Shell, etc.	Thick- ness Feet	Depth Feet
(1) Owner of Land: <u>M. S. Knowlton</u> (Name)	Clay	12	12
<u>Perthshire, Mississippi</u> (Address)	Coarse sand	38	150
(2) Location: <u>1/4, 1/4, Sec. 3 T24N R7W</u>	Gravel	18	168
<u>_____</u> miles, of <u>Perthshire</u>	Clay	192	360
(distance) (direction) (Nearest Town)	Fine sand	6	366
(3) Topography: <u>flat</u>	Shale sand strks.	59	425
(Hilly) (Flat) (Level)	Fine sand	20	445
(4) Purpose of Well: <u>domestic</u>	M. Fine sand	23	468
(Domestic Irrigation Municipal, Industrial, Other)	Pack sand	23	491
Information upon completion of well:	M. Sand	22	513
(1) Diameter <u>3"</u> inches.	Fine sand	22	535
(2) Total Depth <u>535' -1"</u> feet.	Clay		536
(3) Water Level <u>27' -2"</u> feet below top of			
ground. <u>105' -1"</u> <u>4"</u> surface casing			
(4) Cased to <u>360' -7"</u> , Size <u>3"</u>			
(5) Screen: Size <u>3"</u> , Length <u>30' -5"</u>			
<u>39'</u> of <u>3"</u> blank			
(6) Were any formations sealed against pollution?			
<u>yes</u> yes, <u>no</u> no.			
If YES depth of formation <u>Packer</u> at the			
top of screen.			
Why <u>To eliminate all other</u>			
formations.			
Drillers Remarks:			

**CODED**

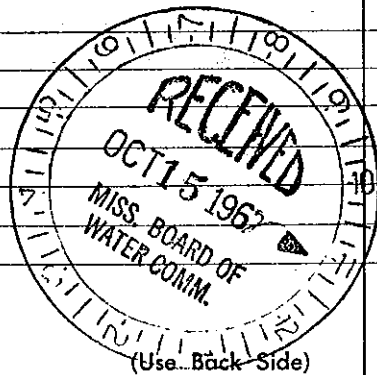

Well No.

Mail this copy to Board of Water Commissioners 429 Miss. St. Jackson, Miss