

Bolivar MISSISSIPPI BOARD OF WATER COMMISSIONERS

C 80 CODED
8-8-66 WATER WELL DRILLERS LOG CODED

Date: 8/8, 1966, Driller: Delta Well Supply County Bolivar
(Name)

(1) Owner of Land	Description & Color of Materials Sand, Clay, Red Clay, Shell, etc.	Thick- ness Feet	Depth Feet
<u>Amiel Earle</u> (Name) <u>Lumberton, Miss.</u> (Address)	<u>Top soil</u>	<u>18</u>	
(2) Location: <u>NW</u> 1/4, <u>24 7</u> Sec. <u>20 T14 R4W</u> <u>2</u> miles <u>So. East</u> of <u>Lumberton</u> (distance) (direction) (Nearest Town)	<u>Fine sand with clay streaks Clay Blue and Lime Coarse sand & gravel</u>	<u>60</u> <u>78</u> <u>20</u> <u>98</u>	
(3) Topography: <input checked="" type="checkbox"/> (Hilly) <input type="checkbox"/> (Flat) <input type="checkbox"/> (Level)			
(4) Purpose of Well: <u>Irrigation</u> (Domestic, Irrigation, Municipal, Industrial, Other)			

Information upon completion of well:


- (1) Diameter 16 inches.
- (2) Total Depth 132 feet.
- (3) Water Level 22 feet below top of ground.
- (4) Cased to 92, Size 16
- (5) Screen: Size 16, Length 40 ft.
- (6) Were any formations sealed against pollution?
_____ yes, no.

If YES depth of formation _____

Why _____

Drillers Remarks: _____

CODED

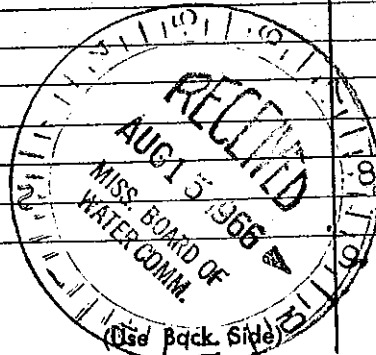

Well No.

Mail this copy to Board of Water Commissioners 429 Miss. St. Jackson, Miss.