

Bolivar MISSISSIPPI BOARD OF WATER COMMISSIONERS

C
 8-66 ⁸¹ CODED WATER WELL DRILLERS LOG ^{COB} *Bolivar*
 Date: *8/18*, 1966, Driller: *Boley Drilling Co* County: *Washington*

(1) Owner of Land:	Description & Color of Materials Sand, Clay, Red Clay, Shell, etc.	Thick- ness Feet	Depth Feet
<i>W T Dunlap</i> (Name) <i>Rosedale, Miss.</i> (Address)	<i>Clay</i>		<i>20</i>
	<i>Sand</i>		<i>70</i>
(2) Location: <i>NW 1/4, NW 1/4, Sec. 33 24 43</i> TN RW	<i>Gravel</i>		<i>170</i>
<i>4</i> miles <i>NW</i> of <i>Rosedale</i> (distance) (direction) (Nearest Town)	<i>Mud</i>		<i>320</i>
(3) Topography: <i>Flat</i> (Hilly) (Flat) (Level)	<i>Mud + Sand</i>		<i>380</i>
(4) Purpose of Well: <i>domestic</i> (Domestic Irrigation Municipal, Industrial, Other)	<i>Sand</i>		<i>401</i>

CODED


Information upon completion of well:

- (1) Diameter *2 1/2 x 2* inches.
- (2) Total Depth *401* feet.
- (3) Water Level *25* feet below top of ground.
- (4) Cased to *all way* Size *2 1/2 x 2*
- (5) Screen: Size *2*, Length *10 ft*
- (6) Were any formations sealed against pollution?
 yes, no.

2 1/2" - 105'
2" - 286'

If YES depth of formation _____
 Why _____

Drillers Remarks: *Pump HP 1*
6 PM - 10
Power, Etc

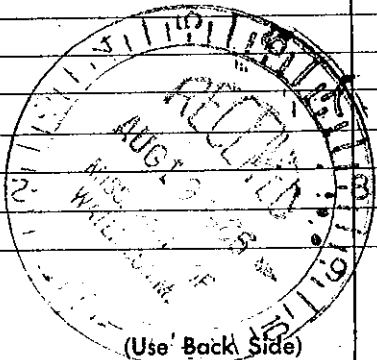

Well No. _____