

CODED

MISSISSIPPI BOARD OF WATER COMMISSIONERS
416 North State Street
Jackson, Mississippi 39201

COED

301ivar
C 87
6-67

WATER WELL DRILLERS LOG

5-25 1967 Fitz Causey Turbines Ass Bolivar
date well completed firm name county well located

LANDOWNER	description of formations encountered	from	to
<u>Campbell Co</u>			
<u>Concordia R. Riv. Miss</u>			
<u>Clarksdale Miss</u> (mailing address)	<u>Topsoil</u>		<u>22</u>
	<u>Sand</u>	<u>22</u>	<u>48</u>
	<u>Sand + Peaches</u>	<u>48</u>	<u>170</u>
	<u>Rock 8"</u>	<u>170</u>	<u>170^B</u>
	<u>Clay + Sand</u>	<u>170^B</u>	<u>190</u>
	<u>Rock 6"</u>	<u>190</u>	<u>190^E</u>
	<u>Clay + Sand</u>	<u>190^E</u>	<u>283</u>
	<u>Clay</u>	<u>283</u>	<u>349</u>
	<u>Fine Sand (White)</u>	<u>349</u>	<u>450¹⁰</u>
	<u>Clay at 480¹⁰</u>		
	<u>cut to</u>	<u>457¹⁰</u>	
	<u>all clay</u>		


WELL LOCATION:

sec 5 T 24 N R 7 W
3 miles NNE of Garrison
(distance) (direction) (nearest town)

WELL PURPOSE: Headquarters
(home, irrigation, municipal, industrial)

WELL COMPLETION DATA:

- (1) diameter (inches) 2"
- (2) total depth (feet) 450
- (3) static water level (feet) 30 below top of ground.
- (4) casing Galvanized pipe (material) 430 (depth)
2' (size) if telescope see back.
- (5) screen 10' (length) 430 (depth to top)
2 1/2" (size) Stainless Steel (material)
- (6) pump 3/4 (HP) 17 (yield gpm)
9 feet (type power)
- (7) electric log no (yes or no)
(organization running log)
- (8) how well bottom plugged Wash Valve

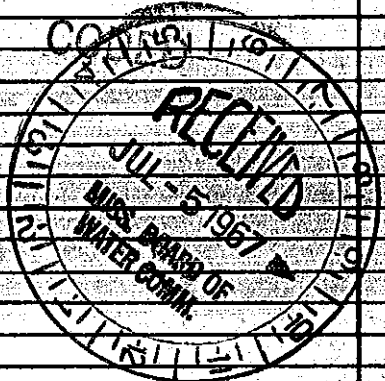

PH 8
9 am - trace
Headress - 1.90%

Fine white sand

DRILLERS REMARKS: