

CODED

BOLIVAR  
C-88  
3-68

MISSISSIPPI  
BOARD OF WATER COMMISSIONERS  
416 North State Street  
Jackson, Mississippi 39201

CODED

3/19/68  
On

WATER WELL DRILLERS LOG

C 2624

March 4, 19 68 Layne-Central Company Bolivar  
date well completed firm name county well located

LANDOWNER: Dalton Taylor	description of formations encountered	from	to
Rosedale, Mississippi (mailing address)			
WELL LOCATION: sec. 35-T-24-N-5 R-8-E	Fine sand	7	24
	Clay balls	24	36
	Coarse sand, clay balls	36	55
	Coarse sand, pea gravel and gravel	55	102
	Clay	102	


3 miles north of Rosedale  
(distance) (direction) (nearest town)

WELL PURPOSE: irrigation  
(home, irrigation, municipal, industrial)

WELL COMPLETION DATA:

- (1) diameter (inches) 10
- (2) total depth (feet) 102
- (3) static water level (feet) 16' 1" above top of ground.
- (4) casing steel, 72' (material) (depth)  
10" (size) if telescope see back.
- (5) screen 30' (length), 102' (depth to top)  
10" (size) Armco (material)
- (6) pump 15 (HP), 800 (yield gpm)  
electric (type power)
- (7) electric log no (yes or no)  
(organization running log)
- (8) how well bottom plugged plate

CODED

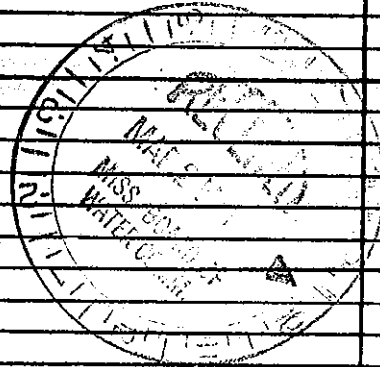

DRILLERS REMARKS: