

**BOLIVER**  
 C 89  
 4-68

MISSISSIPPI  
 BOARD OF WATER COMMISSIONERS  
 416 North State Street  
 Jackson, Mississippi 39201

CODED

WATER WELL DRILLERS LOG

4/12 1968 Delta Well & Supply Co Bolivar  
 date well completed firm name county well located

LANDOWNER:  
 F. N. Armstrong  
 Sumner, Miss.  
 (mailing address)

WELL LOCATION:  
 sec 19 T 24 N R 7 E  
 2 miles So Sumner  
 (distance) (direction) (nearest town)

WELL PURPOSE: Water  
 (home, irrigation, municipal, industrial)

description of formations encountered	from	to
Clay	0	6
fine sand	6	148
Clay	148	245
is. sand	245	250
Clay	250	314
fine sand	314	397
Clay	397	399
soft sand	399	490
fine to med		

WELL COMPLETION DATA:

(1) diameter (inches) 4 1/2

(2) total depth (feet) 462

(3) static water level (feet) 23 below above top of ground.

(4) casing Gal. pipe  
 (material) (depth)  
 (size) if telescope see back.


(5) screen 20  
 (length) (depth to top)  
2 standard steel  
 (size) (material)

(6) pump 1 23  
 (HP) (yield gpm)  
3/4  
 (type power)

(7) electric log (yes or no)  
 (organization running log)

(8) how well bottom plugged AP valve

CODED

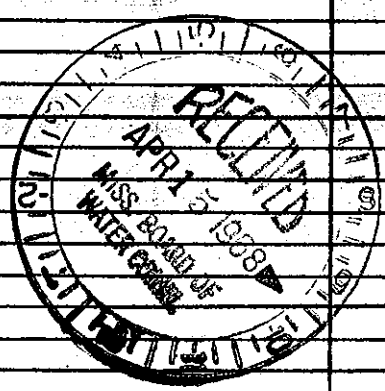

DRILLERS REMARKS: