

~~MA 77~~ C 90

11-12-65 WATER WELL DRILLERS LOG

**CODEC**

Date: 11/12, 1965, Driller: Dutton Wells Supply County Bolivar  
(Name)

(1) Owner of Land: Louise Sims  
(Name)  
Cleveland  
(Address)  
18 24 7  
(2) Location: 1/4, 1/4, Sec 27  
2 miles to south of Union  
(distance) (direction) (Nearest Town)  
(3) Topography:  (Flat) (Level)  
(4) Purpose of Well: Fish & Ducks  
(Domestic Irrigation, Municipal, Industrial, Other)

Description & Color of Materials Sand, Clay, Red Clay, Shell, etc.	Thick- ness Feet	Depth Feet
<u>Clay</u>	<u>75</u>	
<u>Fine sand</u>	<u>20</u>	<u>95</u>
<u>Sand &amp; gravel</u>	<u>48</u>	<u>143</u>


Information upon completion of well:

- (1) Diameter 12 inches.  
(2) Total Depth 143 feet.  
(3) Water Level 23 feet below top of ground.  
(4) Cased to \_\_\_\_\_ Size \_\_\_\_\_  
(5) Screen Size 12 Length 38  
(6) Were any formations sealed against pollution?  
\_\_\_\_\_ yes, \_\_\_\_\_ no.

If YES depth of formation \_\_\_\_\_  
Why \_\_\_\_\_

Drillers Remarks: \_\_\_\_\_  
Id in G. P. M.: 2000  
power: L.P. Gas

**CODEC**

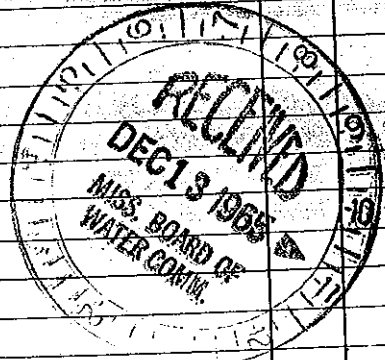

Well No. \_\_\_\_\_

(Use Back Side)

mail this copy to Board of Water Commissioners 429 Miss. St. Jackson, Miss