


CODED

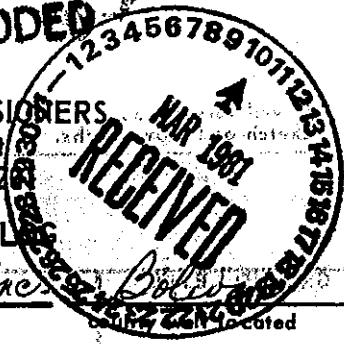

BOLIVAR

C120

7-1-80

Elog # 60

MISSISSIPPI BOARD OF WATER COMMISSIONERS
416 North State Street
Jackson, Mississippi 39201

WATER WELL DRILLERS LOG

July 1, 1980 date well completed
Robert E. Ratliff Co. Inc. firm name

LANDOWNER: <u>town of Gunnison, Gunnison Mississippi</u> (mailing address)	description of formations encountered	from	to
	Top soil	0	10
	Sand	10	140
	Gravel	140	170
	Hard Clay	170	332
	Sand	332	395
	Hard Clay	395	425
	Sand	425	510
	Clay	510	518

WELL LOCATION:
sec. 8 T 240 R 7 E
Center of town 0 miles of Gunnison
(distance) (direction) (nearest town)

WELL PURPOSE: municipal
(home, irrigation, municipal, industrial)

WELL COMPLETION DATA:

(1) diameter (inches) 10x6

(2) total depth (feet) 510'

(3) static water level (feet) _____ below/above top of ground.

(4) casing steel 410
(material) (depth)
10"
(size) if telescope see back.

(5) screen 60'
(length) (depth to top)
6" stainless steel
(size) (material)

(6) pump 30 300
(HP) (yield gpm)
electric
(type power)

(7) electric log yes
(yes or no)
State
(organization running log)

(8) how well bottom plugged B.P.V.

DRILLERS REMARKS:

