

FROM :

FAX NO. :

Nov. 26 2005 12:12PM P1

GW40819

County: Bolivar
 Permit #: GW 41290
 Driller: COOK Drilling
 Date drilling completed: 6-7-06
6/7/05

State Well Report
Part I

Mississippi Department of Environmental Quality
 Office of Land and Water Resources
 P.O. Box 10631
 Jackson, MS 39288-0631
 (601)961-3210
 (601)354-6938 (fax)

For Office Use Only:
 Applicant: _____
 Well #: C-159
 L. S. Identifier: _____
 B-log #: _____

State Law requires that this report be prepared by the driller in detail and filed with the Department within 30 days of completion of drilling of the well.

Well Owner Information		Well Location	
Owner Name: <u>Robinson Long</u>	Latitude: <u>33-53-084</u>	Longitude: <u>91-01-347</u>	
Mailing Address: <u>P.O. Box 575</u>	Method of Lat/Long (circle one): <u>Conventional Survey</u>		
<u>Rosedale La 38769</u>	USGS quad, Hand-held GPS, Survey-grade GPS		
City: _____ State: _____ Zip Code: _____	<u>SW 1/4</u> of <u>NE 1/4</u> Sec <u>34</u> Twp <u>24N</u> Rng <u>8W</u>		
Telephone No: <u>601-759-3511</u>	Distance: <u>7</u> Miles Direction: <u>NW</u> of Nearest Town: <u>Rosedale</u>		

Well Data

Purpose of Well: (circle one) Home Industrial Public Supply Irrigation Fish Culture Other: _____

Date well drilled started: 6-7-06 Date well drilling completed: 6-7-06

If flowing, method of flow regulation: Valve _____ Other (describe): _____

Static Water Level: 20 feet above or below (circle one) land surface Date measured: 6-7-06

Method of Measurement (circle one) steel tape electric tape air line other: _____

Hole depth: 120' Well depth: 120' Well grouted to a depth of 10' feet

Type of grout (circle one): Cement Bentonite Mix

Casing length: 80 feet Casing diameter: 16 inches Type of casing: PVC

Screen length: 40 feet Screen diameter: 1 1/2 inches Type of screen: PVC

Screen slot size: 0.50 inches Setting depth: From 40 feet to 120 feet

Type of completion (circle all applicable): Gravel packed Underdrained Telescoped Open hole Natural Development Other (describe): _____

Top of log pipe: _____ feet. If telescoped or more than one screen, describe on back of page

Logs run (circle all applicable): No log run Electric Gamma Ray Density Sonic Neutron Other: _____

Name of organization running logs: _____


I certify that this well was drilled, constructed, and completed in accordance with all applicable requirements of the Mississippi Department of Environmental Quality and/or the Mississippi Department of Health regulations and state laws.

COOK Drilling Co. Inc. First Name of Well Contractor and License No. _____
Salvador Cook Signature of Water Well Contractor

GW ~~40819~~ 40819

C-159


Ground level

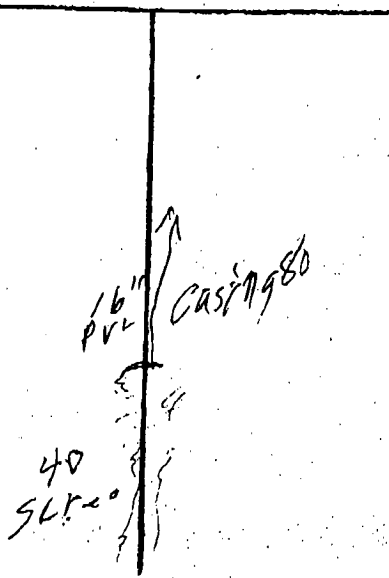

Description of Formations Encountered	From	To
Top Soil	100	12'
Fine sand	12'	40'
Fine to med sand	40'	50'
Med to coarse sand	51'	62'
Coarse sand	62'	81'
Coarse sand & gravel	81'	120'

At _____ show location of _____

Sketch the property layout and include the following: 1) the well location; 2) any permanent structures on the property that may be in locating the well; 3) any roads, power lines, or other items that may aid in locating the property and the well. Indicate direction.

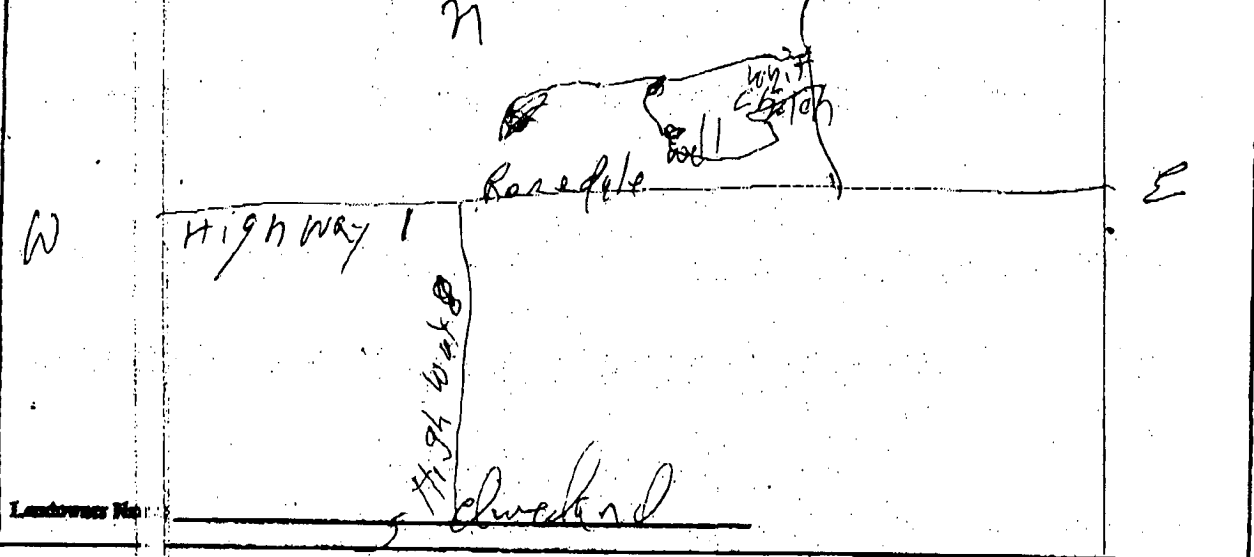

Landowner Name

Lubing Cook
Signature of Water Well Customer

FROM :

FAX NO. :

Nov. 26 2005 12:13PM P2

GW40819

JAMIE WELLS REPORT

Part 2

Pump Installer's Completion Report
Mississippi Department of Environmental Quality
Office of Land and Water Resources
P.O. Box 10631
Jackson, MS 39288-0631
(601)961-4210
(601)254-6926 (fax)

For Office Use Only:

Applfor:
Well #: C-159
Elevation:

County: DOLLAR
Permit #: GW 40819
Deline: Cook Drilling
Date completed: 8-9-05

This report should be prepared by the pump installer in detail and filed with the Department within 30 days of the installation of pump.

Well Owner Information: Owner Name: Robina & Son, P.O. Box 595, Rosedale, MS 38769. Telephone No: 662-758-3511. Well Location: Latitude: 35°57'08.4", Longitude: 091°01'34.7". Method of Lat/Long: Conventional Survey. USGS quad, Hand-held GPS, Survey-grade GPS. Distance: 4 miles NW of Rosedale, MS.

Pump Type: Jet, Submersible, Piston, Turbine, Rotary, Flowing Well. Power Type: Diesel Engine, Gasoline Engine, Manual Gas, Electric Motor, Hand, Tractor PTO, Windmill, Other. Horse Power Rating of Motor: 75. Setting Depth: 70 feet. Number of Stages: 1 1/4".

Pump Test Data: Date Well Tested, Static Water Level (A), Pumping Water Level (B), Drawdown (B), Test Pumping Rate, Duration of Pump Test. Method of Measuring Water Level: Air Line, Electric Measuring Line, Steel Tape. Well yielded GPM with a drawdown of feet after hours of pumping.

I HEREBY CERTIFY that the above statements are true to the best of my knowledge.
Print Name of Pump Installer and License No. (if applicable): Cook Drilling, Inc.
Signature of Pump Installer: Jamie Wells