

STATE WELL REPORT

Part 1

Driller's Log

Mississippi Department of Environmental Quality
Office of Land and Water Resources
P.O. Box 2309
Jackson, MS 39225-2309
(601)961-5210
(601)360-0535 (fax)

For Office Use Only:

Well #: 0200
Aquifer: _____
E-Log #: _____

County: Bolivar
Permit #: GW-47394
Driller: J. NEWCOME 0-773
Date drilling completed: 6-10-2013

State Law requires that this report be prepared by the license holder responsible for the work and filed with the Department at the above address within 30 days of completion of drilling of the well or borehole.

Well Owner Information (Landowner if borehole is not for a water well)	Well or Borehole Location
Owner Name: <u>David Kirk Patrick</u>	Latitude: <u>33° 55' 23"</u> Longitude: <u>090° 53' 18"</u>
Mailing Address: <u>805 University Street</u>	Method of Lat/Long (check one): Conventional Survey _____, Hand-held GPS <input checked="" type="checkbox"/> , Survey-grade GPS _____
<u>Cleveland</u> MS <u>38732</u>	USGS quad _____, <u>SE</u> 1/4 <u>SE</u> 1/4, Sec <u>14</u> T <u>24N</u> R <u>07W</u>
City State Zip Code	<u>3.4</u> Miles <u>S.E.</u> of <u>GUNNISON</u>
Telephone No. (____) _____	(Distance) (Direction) (Nearest Town)

Well / Borehole Data	
Date drilling started: <u>6-10-13</u>	Date drilling completed: <u>6-10-13</u> Hole depth: <u>112</u> Hole diameter: <u>2 1/2"</u>
Location of the source of any surface water used for drilling: <u>SLOUGH</u>	
Method of dosing and volume of Chlorine used in drilling and development: <u>CHLORINE TABLETS</u>	
Logs run (circle all applicable): <input checked="" type="checkbox"/> No log run <input type="checkbox"/> Electric <input type="checkbox"/> Gamma Ray <input type="checkbox"/> Density <input type="checkbox"/> Sonic <input type="checkbox"/> Neutron <input type="checkbox"/> Other: _____	
Name of organization running log(s): _____	
Purpose of borehole (circle one): <input checked="" type="radio"/> Water Well <input type="radio"/> Geotechnical/Geological Investigation <input type="radio"/> Ground Source Heat Pump <input type="radio"/> Seismic Survey <input type="radio"/> Other (describe) _____	
<i>If drilling is not related to water well construction, skip the remainder of this block</i>	
Purpose of Well (circle all applicable): Home <input type="checkbox"/> Industrial <input type="checkbox"/> Public Supply <input checked="" type="checkbox"/> Irrigation <input type="checkbox"/> Fish Culture	
Other (describe): _____	
If a flowing well, method of flow regulation: Valve _____ Other (describe) _____	
Static Water Level: _____ feet [above or below] land surface Date measured: _____ (circle one)	
Method of measurement (circle one): Steel tape <input type="checkbox"/> Electric tape <input type="checkbox"/> Air line <input type="checkbox"/> Other (describe): _____	
Well depth: <u>110</u> Well grouted to a depth of: <u>10</u> feet Type of grout (circle one): Neat Cement <input type="checkbox"/> <input checked="" type="checkbox"/> Bentonite Mix	
Casing length: <u>70</u> feet	Casing diameter: <u>16</u> inches Type of casing: <u>P.V.C.</u>
Screen length: <u>40</u> feet	Screen diameter: <u>16</u> inches Type of screen: <u>P.V.C.</u>
Screen slot size: <u>.050</u> inches Setting depth: From <u>70</u> feet to <u>110</u> feet	
Type of completion (circle all applicable): <input checked="" type="checkbox"/> Gravel packed <input type="checkbox"/> Underreamed <input type="checkbox"/> Open hole <input type="checkbox"/> Natural Development	
Other (describe): _____	
Top of lap pipe or reduction in casing: _____ feet	
<i>If telescoped or more than one screen, describe on next page</i>	

County: Bolivar

Permit #: GW 47394


For Office Use Only:

Well #: C 200

The sketch below only required for water wells

If well telescopes, show depths on sketch.

Ground Level →

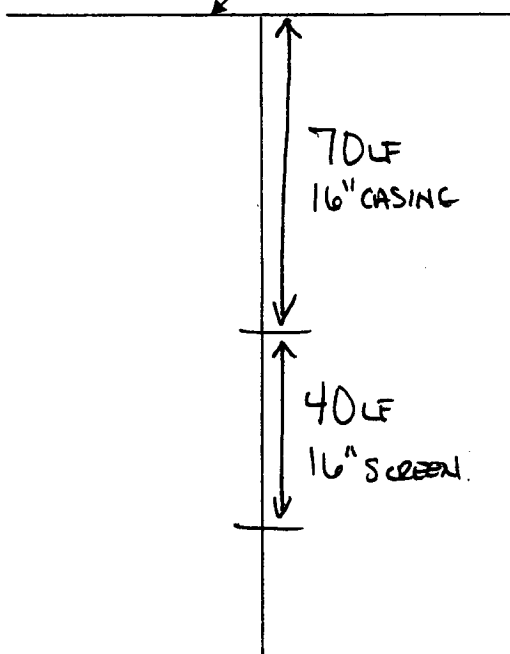

If more than one screen, show location of each on sketch

Description of formations encountered must be provided for all wells and boreholes, unless specifically exempted by regulations

Description of Formations Encountered	From (depth)	To (depth)
TOP SOIL	Ground level	10
CLAY	10	20
SAND	20	50
COARSE SAND/PEBBLES	50	110
BOTTOM	110	112

Sketch the property layout and include the following:

- 1) the well location
- 2) any permanent structures on the property that may aid in locating the well
- 3) any roads, power lines, or other items that may aid in locating the property and the well
- 4) north arrow

SEE MAP

Landowner Name: _____

I HEREBY CERTIFY that the well/borehole was drilled, constructed, and completed in accordance with all applicable requirements of the Mississippi Department of Environmental Quality and the Mississippi Department of Health regulations, if applicable, and state laws.

JOHN NEWCOME 0.973

6-10-2013

[Signature]

Print Name of Responsible Licensee and License No.

Date

Signature of Licensee

STATE WELL REPORT

Part 2

Pump Installer's Completion Report
Mississippi Department of Environmental Quality
Office of Land and Water Resources
P.O. Box 2309
Jackson, MS 39225-2309
(601)961-5210
(601) 360-0535 (fax)

County: Bolivar
Permit #: 6W-47394
Driller: J. Newcome 0773
Date completed: 6.10.13
Copy information from block on Part 1

For Office Use Only:
Well #: CA00
Aquifer: _____

This part of the report must be completed by a licensed water well contractor or a licensed pump installer. A copy of Part 1 of the report must be attached and both parts filed with the Department at the above address within 30 days of well completion.

Well Owner Information			Well Location		
Owner Name: <u>David Kirkpatrick</u>	Latitude: <u>33° 55' 23"</u> Longitude: <u>90° 53' 18"</u>				
Mailing Address: <u>805 University Street</u>	Method of Lat/Long (check one): Conventional Survey _____, USGS quad _____, Hand-held GPS <input checked="" type="checkbox"/> , Survey-grade GPS _____				
<u>Cleveland</u> City	<u>MS</u> State	<u>38732</u> Zip Code			
Telephone No. (____) _____	<u>SE 1/4 SE 1/4, Sec 14</u>	<u>T 24N R 07W</u>			
	<u>3.4</u> Miles (Distance)	<u>S.E.</u> of <u>Gunnison</u> (Nearest Town)			

Pump Type (circle one)
Submersible Turbine Air Lift Centrifugal Flowing Well Jet Piston Rotary Other (describe): _____
Date Pump Installed: 6.11.13 Rated Pump Capacity: 2500 Gallons Per Minute
Is This Pump (circle one): New Repaired Replacement


Power Type (circle one)
Electric Diesel Gasoline Natural Gas Tractor PTO Windmill Other (describe): _____
Horse Power Rating of Motor: 60hp Setting Depth: 70 feet Number of Stages: 1

Pump Test Data for Non Flowing Well
Date Well Tested: Not Tested Duration of Pump Test (minimum 4 hours): _____ hours
Static Water Level (A): _____ Feet Below Land Surface Pumping Water Level (B): _____ Feet Below Land Surface
Drawdown [(B) - (A)]: _____ Feet Below Land Surface Test Pumping Rate: _____ Gallons Per Minute
Method of measurement (circle one): Steel tape Electric tape Air line Other (describe): _____

Pump Test Data for Flowing Well
Measured shut in head: _____ feet Not Tested
Well yielded _____ GPM with a drawdown of _____ feet after _____ hours of pumping

Meter Installation
Meter Manufacturer: Wometer Meter Serial Number: _____
Meter Model Number/Name: _____ Type of Meter: _____
Totalizer Register Unit and Multiplier Factor (AF x .001, gal x 1000, etc): _____
Installation Date: _____ Meter installed by: _____
Is This Meter (circle one): New Repaired Replacement
Important: By submitting the above information you are certifying that this meter was installed to manufacturer standards. For agricultural wells, a list of approved meters is on the MDEQ website.

I HEREBY CERTIFY that the above statements are true to the best of my knowledge.
Hubbard Stephens 7411-P 4/14/14 Hubbard Stephens
Print Name of Pump Installer and License No. (if applicable) Date Signature of Pump Installer

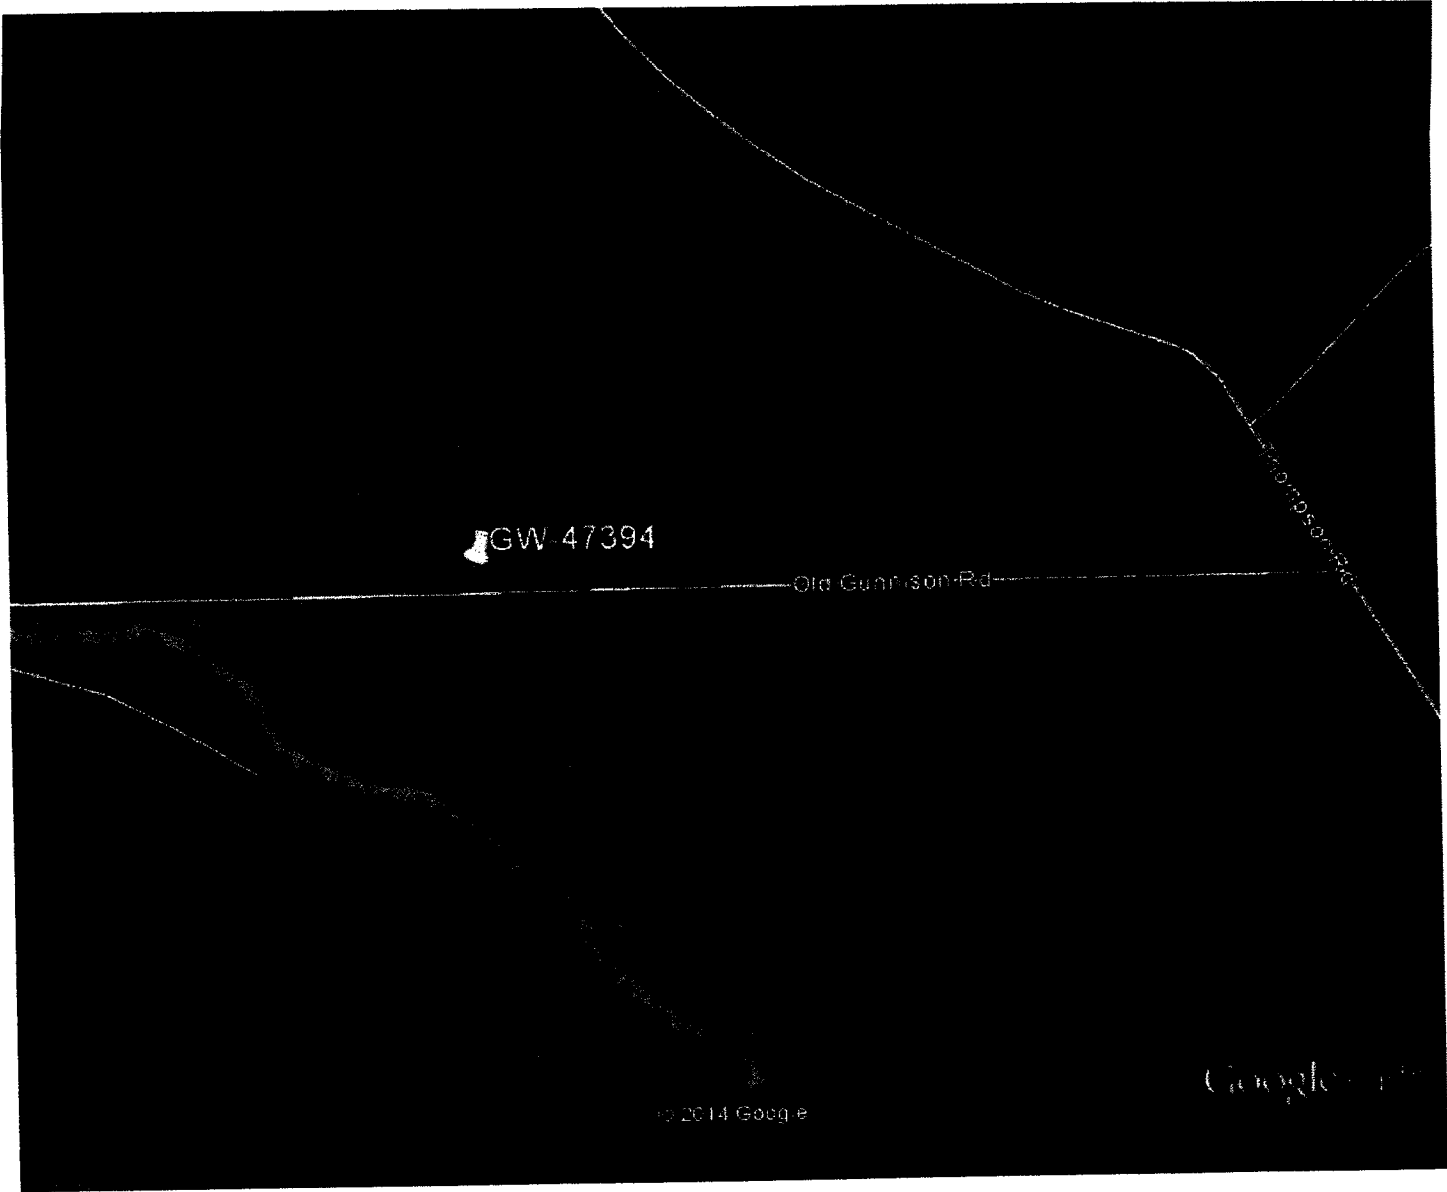

Google earth

