	STATE WELL REPORT	For Office Use Only:
County: Bolivar	Part 1	well #: <u>C 204</u>
Permit #: GW-49535	Driller's Log Mississippi Department of Environmental Quality	Aquifer:
Driller: Irrigation Equipment, Inc.	Office of Land and Water Resources P.O. Box 2309	E-Log #:
Date drilling completed: 5-18-16	Jackson, MS 39225-2309	
	┘ (601) 961-5210 (601) 360-0535 (fax)	
State Law requires that this report	be prepared by the license holder responsible fo	r the work and filed with the
Department at the above address w Well Owner Informa	vithin 30 days of completion of drilling of the we	ell or borehole. Orehole Location
(Landowner if borehole is not fo		
Owner Name: Lagniappe Farms Part	nership Latitude: 33 57' 46.6"	Longitude: 90 53' 39.3"
Mailing Address: 413 Norman Circle	Method of Lat/Long (check of	ne): 🔲 Conventional Survey,
		d GPS, 🔲 Survey-grade GPS
Cleveland MS City Stat		[/] ¼, Sec <u>2</u> T <u>24N</u> R <u>7W</u>
Telephone No. () -	Miles St (Distance) (Direc	
	Well / Borehole Data	
- · · · · · · · · · · · · · · · · · · ·		71
		7' Hole diameter: 24"
Location of the source of any surface wa	ter used for drilling: Surface Water	
Method of dosing and volume of Chlorine	e used in drilling and development: 50 PPM	
-	e used in drilling and development: 50 PPM	Neutron D Other:
		Neutron [] Other:
Logs run (check all applicable): 🛛 No log	g run 🗋 Electric 🗋 Gamma Ray 🗋 Density 🗍 Sonic [
Logs run (check all applicable): 🛛 No log Name of organization running log(s): Purpose of borehole (check one): 🕅 W	g run] Electric] Gamma Ray] Density] Sonic]	
Logs run (check all applicable): 🛛 No log Name of organization running log(s): Purpose of borehole (check one): 🖾 W 🔲 S	g run [] Electric [] Gamma Ray [] Density [] Sonic [/ater Well [] Geotechnical/Geological Investigation Geismic Survey [] Other (<i>describe</i>)	Ground Source Heat Pump
Logs run (check all applicable): 🛛 No log Name of organization running log(s): Purpose of borehole (check one): 🖾 W 🗌 S	g run] Electric] Gamma Ray] Density] Sonic]	Ground Source Heat Pump
Logs run (check all applicable): 🛛 No log Name of organization running log(s): Purpose of borehole (check one): 🖾 W 🗆 S <i>If drilling is not rel</i> a	g run [] Electric [] Gamma Ray [] Density [] Sonic [/ater Well [] Geotechnical/Geological Investigation Geismic Survey [] Other (<i>describe</i>)	Ground Source Heat Pump
Logs run (check all applicable): X No log Name of organization running log(s): Purpose of borehole (check one): X W C S <i>If drilling is not rel</i> Purpose of Well <i>(check all applicable)</i> : C	g run Electric Gamma Ray Density Sonic Vater Well Geotechnical/Geological Investigation Geismic Survey Other (<i>describe</i>) ated to water well construction, skip the remained	Ground Source Heat Pump der of this block sh Culture
Logs run (check all applicable): No log Name of organization running log(s): Purpose of borehole (check one): N <i>If drilling is not rela</i> Purpose of Well (check all applicable): Other (describe):	g run [] Electric [] Gamma Ray [] Density [] Sonic [/ater Well [] Geotechnical/Geological Investigation Seismic Survey [] Other (<i>describe</i>) <i>ated to water well construction, skip the remaine</i> Home [] Industrial [] Public Supply [] Irrigation [] Fis	Ground Source Heat Pump
Logs run (check all applicable): No log Name of organization running log(s): Purpose of borehole (check one): N <i>If drilling is not rela</i> Purpose of Well (check all applicable): Other (describe): If a flowing well, method of flow regulation	g run Electric G amma Ray Density Vater Well Geotechnical/Geological Investigation Geismic Survey Other (describe) ated to water well construction, skip the remained Home Industrial Public Supply Irrigation Fis Image: Structure Other (describe)	Ground Source Heat Pump
Logs run (check all applicable): No log Name of organization running log(s): Purpose of borehole (check one): No Is <i>If drilling is not rela</i> Purpose of Well (check all applicable): Other (describe): Other (describe): If a flowing well, method of flow regulation Static Water Level:f	g run ☐ Electric ☐ Gamma Ray ☐ Density ☐ Sonic [/ater Well ☐ Geotechnical/Geological Investigation Geismic Survey ☐ Other (<i>describe</i>) <i>ated to water well construction, skip the remaine</i> Home ☐ Industrial ☐ Public Supply ⊠ Irrigation ☐ Fis	Ground Source Heat Pump
Logs run (check all applicable): I No log Name of organization running log(s): Purpose of borehole (check one): I W If drilling is not relation Purpose of Well (check all applicable): I Purpose of Well (check all applicable): I Other (describe): If a flowing well, method of flow regulation Static Water Level: 24f Method of Measurement (check one) I	g run Electric Gamma Ray Density Sonic /ater Well Geotechnical/Geological Investigation Seismic Survey Other (describe)	Ground Source Heat Pump der of this block sh Culture asured: <u>5-19-16</u> be)
Logs run (check all applicable): No log Name of organization running log(s): Purpose of borehole (check one): No <i>If drilling is not rela</i> Purpose of Well (check all applicable): Other (describe): Other (describe): If a flowing well, method of flow regulation Static Water Level: <u>24</u> Method of Measurement (check one) Well depth: <u>127'</u> Well grouted to a	g run Electric Gamma Ray Density Sonic Vater Well Geotechnical/Geological Investigation Seismic Survey Other (describe)	☐ Ground Source Heat Pump der of this block sh Culture asured: <u>5-19-16</u> be)] Neat Cement ⊠ Bentonite □ M
Logs run (check all applicable): ⊠ No log Name of organization running log(s): Purpose of borehole (check one): ⊠ W □ S <i>If drilling is not reliced for the state of the s</i>	g run Electric G amma Ray Density Vater Well Geotechnical/Geological Investigation Seismic Survey Other (describe) ated to water well construction, skip the remained Home Industrial Public Supply Irrigation Fis Image: Set of the set of t	☐ Ground Source Heat Pump der of this block sh Culture asured: <u>5-19-16</u> be)] Neat Cement ⊠ Bentonite □ M of casing: <u>PVC</u>
Logs run (check all applicable): Name of organization running log(s): Purpose of borehole (check one): If drilling is not related in the second sec	g run Electric G amma Ray Density Vater Well Geotechnical/Geological Investigation Seismic Survey Other (describe) ated to water well construction, skip the remained Home Industrial Public Supply Irrigation Home Industrial Public Supply Irrigation Fis Image: Second structure Other (describe) in: Valve Context (describe) in: Valve Context (describe) in: Valve Context (describe) in: Valve Context (describe) in: Valve in: Valve Other (describe) in: Valve Other (describe) in: Valve Context (describe) in: Valve in: Valve Other (describe) in: Valve	☐ Ground Source Heat Pump der of this block sh Culture asured: <u>5-19-16</u> be)] Neat Cement ⊠ Bentonite □ M of casing: <u>PVC</u>
Logs run (check all applicable): ⊠ No log Name of organization running log(s): Purpose of borehole (check one): ⊠ W □ S <i>If drilling is not related for the state of the s</i>	g run Electric G amma Ray Density Vater Well Geotechnical/Geological Investigation Seismic Survey Other (describe) ated to water well construction, skip the remained Home Industrial Public Supply Irrigation Fis I Home Industrial Public Supply I Home Industrial Public Supply I Home Industrial Public Supply I Home Industrial Other (describe) I Home Other (describe) Steel [above or [2] below] land surface Date mean (check one) Steel tape Electric tape Air line Other: (describe) Casing diameter: 16 inches Type of grout (check one): Casing diameter: 16 inches Type of group	Ground Source Heat Pump der of this block sh Culture asured: 5-19-16 be) Neat Cement ⊠ Bentonite □ M of casing: PVC of screen: PVC eet to
Logs run (check all applicable): ⊠ No log Name of organization running log(s): Purpose of borehole (check one): ⊠ W □ S <i>If drilling is not rela</i> Purpose of Well (check all applicable): □ □ Other (describe): ☆ ☆ ☆ ☆ ☆ □ Other (describe): ☆ ☆ ☆ ☆ ☆ ☆ If a flowing well, method of flow regulation Static Water Level: 24f Method of Measurement (check one) ⊠ Well depth: 127' Well grouted to a Casing length: 40feet Screen length: 40feet Screen slot size:	g run Electric G amma Ray Density Vater Well Geotechnical/Geological Investigation Geismic Survey Other (describe) ated to water well construction, skip the remained Home Industrial Public Supply Irrigation Fis Image: Street tape Electric tape Ater Type of grout (check one): Casing diameter: 16 inches Setting depth: From	Ground Source Heat Pump der of this block sh Culture asured: 5-19-16 be) Neat Cement ⊠ Bentonite □ M of casing: PVC eet to PCC eet to PCC Natural Development

Form: OLWR-SWR-1A (4/13)

.


Weli #:	For Office Use Only:	
	- -	

The sketch below only required for water wells

If well telescopes, show depths on sketch.

County: Bolivar
Permit #: GW-49535

.

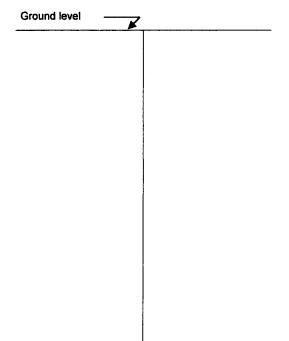

Description of formations encountered must be provided for all wells and boreholes, unless specifically exempted by regulations

Description of Formations Encountered	From (depth)	To (depth)
Clay	Ground level	33
Fine Sand	34	57
Fine Sand & Gravel	58	77
Med. Sand & Gravel	78	127
	· · · · ·	
	1	
	· · · · ·	
· · · · · · · · · · · · · · · · · · ·		
· · · · · · · · · · · · · · · · · · ·		
-		ļ
		<u></u>

If more than one screen, show location of each on sketch

Sketch the property layout and include the following:		
1) the well location		
2) any permanent structures on the property that may	aid in locating the	well
3) any roads, power lines, or other items that may aid	I in locating the prop	perty and the well
4) a north arrow	• • •	
Landowner Name:		<u></u>
		Form: OLWR-SWR-1A (04/08)
I HEREBY CERTIFY that the well/borehole was drilled, con		
requirements of the Mississippi Department of Environmen if applicable, and state laws.	ital Quality and the	Mississippi Department of Health regulations,
0695	7 9 46	Ya
	<u> </u>	
Print Name of Responsible Licensee and License No.	Date	Signature of Licen et OOIVO
		Form: OLWR SWR-/A(4A3)

JUL 1 3 2016

By OLWR

	STATE WELL F	REPORT		Office Use Only:
County: Bolivar	Part 2			C204
Permit #: GW-49535	Pump Installer's Comp	oletion Report		
Driller: Irrigation Equipment, Inc.	Mississippi Department of Env Office of Land and Wate		ty Aquifer:	
Date drilling completed: 5-18-16	P.O. Box 230	-		
Copy information from block on Part 1	Jackson, MS 3922 (601) 961-521			
	(601) 360-0535	(fax)		
This part of the report must be completed				
of the report must be attached and both p Well Owner Information			within 30 day Nell Locatic	
Owner Name: Lagniappe Farms Partr	ership Latitude:	33 57' 46.6"	Longit	ude: 90 53' 39.3"
Mailing Address: 413 Norman Circle	Method	of Lat/Long (chec	cone): 🔲	Conventional Survey,
<u></u>		S quad, 🔀 Hand-	held GPS, [] Survey-grade GPS
Cleveland MS City State	38732 Zip code	½	¼, Sec 2	2 T <u>24N</u> R <u>7W</u>
Telephone No. () -	(Dista	Miles(D	SE c	of <u>Perthshire</u> (Nearest Town)
	Pump Type (check o	ne)		
🖸 Submersible 🛛 Turbine 🗖 Air Lift 🗖 C			V 🗋 Other (a	lescribe):
Date Pump Installed 5-19-16	Rated Pum			
		ne)	 .	
Is This Pump (check one): 🛛 New 🗌 Re	paired Replacement Power Type (check o	,	be):	· · · · · · · · · · · · · · · · · · ·
Is This Pump (check one): New Re	aired Replacement Power Type (check o al Gas Tractor PTO Windmi	II 📋 Other (descri		Stages: 2
Is This Pump <i>(check one)</i> : 🛛 New 🗌 Re 🛛 Electric 🗆 Diesel 🗆 Gasoline 🗖 Natur	aired	II [] Other (descri		Stages: 2
Is This Pump (check one): New Re	Daired Replacement Power Type (check o al Gas Tractor PTO Windmin Setting Depth: 70 Pump Test Data for Non Flo	II (Other (descri	Number of	
Is This Pump (check one): New Re	Daired Replacement Power Type (check o al Gas Tractor PTO Windmin Setting Depth: 70 Pump Test Data for Non Flo	II Other (descri	Number of	urs): Hours
Is This Pump (check one): New Re	Daired Replacement Power Type (check o al Gas Tractor PTO Windmin Setting Depth: 70 Pump Test Data for Non Flo Duration et Below Land Surface Pumping	Other (description) feet feet feet owing Well of Pump Test (m g Water Level (B):	Number of	urs): Hours Feet Below Land Surface
Is This Pump (check one): New Re	Daired Replacement Power Type (check o al Gas Tractor PTO Windmin Setting Depth: 70 Pump Test Data for Non Flo Duration et Below Land Surface Pumping	Other (description) feet feet feet owing Well of Pump Test (m g Water Level (B):	Number of	urs): Hours Feet Below Land Surface
Is This Pump (check one): New Re	Daired Replacement Power Type (check or al Gas Tractor PTO Setting Depth: 70 Pump Test Data for Non Floc Duration Duration Duration et Below Land Surface Test	Other (description) feet feet owing Well of Pump Test (m g Water Level (B): Pumping Rate:	Number of	urs): Hours Feet Below Land Surface
Is This Pump (check one): New Re	Daired Replacement Power Type (check or al Gas Tractor PTO Setting Depth: 70 Pump Test Data for Non Floc Duration Duration Duration et Below Land Surface Test	Other (description) feet feet owing Well of Pump Test (m g Water Level (B): Pumping Rate: ne Other (description)	Number of	urs): Hours Feet Below Land Surface
Is This Pump (check one): New Re Electric Diesel Gasoline Natur Horse Power Rating of Motor: 60 Date Well Tested: Static Water Level (A): Fe Drawdown [(B) - (A)]:	Daired Replacement Power Type (check or al Gas Tractor PTO Setting Depth: 70 Pump Test Data for Non Floc Duration Duration Duration Steel Below Land Surface Pumping Steel tape Electric tape Air Iii	Other (description) feet feet owing Well of Pump Test (m g Water Level (B): Pumping Rate: ne Other (description)	Number of	urs): Hours Feet Below Land Surface
Is This Pump (check one): New Re Electric Diesel Gasoline Nature Horse Power Rating of Motor: 60 Date Well Tested: Static Water Level (A): Fe Drawdown [(B) - (A)]: Method of measurement (check one):	Daired Replacement Power Type (check or al Gas Tractor PTO Windmil Setting Depth: 70 Pump Test Data for Non Floc Duration et Below Land Surface Pumping Feet Below Land Surface Test Steel tape Electric tape Air lin Pump Test Data for Flowing Feet	II Other (descri feet owing Well of Pump Test (m g Water Level (B): Pumping Rate: ne Other (desc ing Well	Number of	urs): Hours Feet Below Land Surface Gallons Per Minute
Is This Pump (check one): New Re Electric Diesel Gasoline Nature Horse Power Rating of Motor: 60 Date Well Tested: Static Water Level (A): Fe Drawdown [(B) - (A)]: Method of measurement (check one): Measured shut in head:	Daired Replacement Power Type (check or al Gas Tractor PTO Windmil Setting Depth: 70 Pump Test Data for Non Floc Duration et Below Land Surface Pumping Feet Below Land Surface Test Steel tape Electric tape Air lin Pump Test Data for Flowing Feet	II Other (descri feet owing Well of Pump Test (m g Water Level (B): Pumping Rate: ne D Other (desc ing Well feet after	Number of	urs): Hours Feet Below Land Surface Gallons Per Minute
Is This Pump (check one): New □ Re Electric □ Diesel □ Gasoline □ Natur Horse Power Rating of Motor: 60 Date Well Tested: Static Water Level (A): Fe Drawdown [(B) - (A)]: Method of measurement (check one): □ Measured shut in head: Well yielded GPM with a	paired Replacement Power Type (check or al Gas Tractor PTO Setting Depth: 70 Pump Test Data for Non Floc Duration et Below Land Surface Pumping Feet Below Land Surface Test Steel tape Electric tape Air lin Pump Test Data for Flowing Feet drawdown of	II Other (description of Pump Test (m) of Pump Test (m) og Water Level (B): Pumping Rate: ne Other (description ing Wellfeet after	Number of	urs): Hours Feet Below Land Surface Gallons Per Minute
Is This Pump (check one): New Re	Daired Replacement Power Type (check or al Gas Tractor PTO Windmil Setting Depth: 70 Pump Test Data for Non Flow Duration at Below Land Surface Pumping Feet Below Land Surface Test Steel tape Electric tape Alter Installation	II Other (descri	Number of	urs): Hours Feet Below Land Surface Gallons Per Minute
Is This Pump (check one): New □ Re Is This Pump (check one): Nature Is Electric □ Diesel □ Gasoline □ Nature Horse Power Rating of Motor: 60 60 Date Well Tested:	Daired Replacement Power Type (check or al Gas Tractor PTO Setting Depth: 70 Pump Test Data for Non Floc Duration Duration Duration et Below Land Surface Pest Steel tape Electric tape Air lin Pump Test Data for Flowing Feet drawdown of	II Other (descri	Number of	urs): Hours Feet Below Land Surface Gallons Per Minute hours of pumping
Is This Pump (check one): New Re Electric Diesel Gasoline Nature Horse Power Rating of Motor: 60 Date Well Tested:	Daired Replacement Power Type (check or al Gas Tractor PTO Setting Depth: 70 Pump Test Data for Non Flo Duration et Below Land Surface Test Steel tape Electric tape Air lin Pump Test Data for Flowing Feet drawdown of	II Other (descri feet owing Well of Pump Test (m g Water Level (B): Pumping Rate: ne Other (desc ing Well feet after r Serial Number: pe of Meter:	Number of	urs): Hours Feet Below Land Surface Gallons Per Minute
Is This Pump (check one): New Re	Daired Replacement Power Type (check or al Gas Tractor PTO Setting Depth: 70 Pump Test Data for Non Floc Duration Duration Duration et Below Land Surface Pest Steel tape Electric tape Air lin Pump Test Data for Flowing Feet drawdown of	II Other (descri feet owing Well of Pump Test (m g Water Level (B): Pumping Rate: ne Other (desc ing Well feet after r Serial Number: pe of Meter:	Number of	urs): Hours Feet Below Land Surface Gallons Per Minute
Is This Pump (check one): New □ Re Is This Pump (check one): New □ Re Is Electric □ Diesel □ Gasoline □ Natur Horse Power Rating of Motor: 60 Date Well Tested: Static Water Level (A): Fe Drawdown [(B) - (A)]: Method of measurement (check one): □ Measured shut in head: Well yielded GPM with a Meter Manufacturer: Meter Model Number/Name: Totalizer Register Unit and Multiplier Fact Installation Date: Is This Meter (check one): □ New □ Re Important: By submitting the above	Daired Replacement Power Type (check or al Gas Tractor PTO Windmil Setting Depth: 70 Pump Test Data for Non Floc Duration et Below Land Surface Pump Test Data for Pumping Feet Below Land Surface Steel tape Electric tape Air lin Pump Test Data for Flow Feet drawdown of Meter Installation Meter Type or (AF x .001, gal x 1000, etc): paired Replacement	II Other (descrifeet feet owing Well of Pump Test (m g Water Level (B): Pumping Rate: ne Other (desc ing Well feet after r Serial Number: be of Meter: t this meter was in	Number of	urs): Hours Feet Below Land Surface Gallons Per Minute
Is This Pump (check one): New □ Re Electric □ Diesel □ Gasoline □ Nature Horse Power Rating of Motor: 60 Date Well Tested:	Daired Replacement Power Type (check or al Gas Tractor PTO Windmil Setting Depth: 70 Pump Test Data for Non Flow Duration et Below Land Surface Pump Test Data for Pumping Feet Below Land Surface Test Steel tape Electric tape Air liit Pump Test Data for Flowing Feet drawdown of Meter Installation Meter installed by: Type poaired Replacement information you are certifying that tural wells, a list of approved meter	II Other (descrifeet feet owing Well of Pump Test (m g Water Level (B): Pumping Rate: ne Other (desc ing Well feet after feet after r Serial Number: be of Meter: t this meter was in rs is on the MDE	Number of	urs): Hours Feet Below Land Surface Gallons Per Minute
Is This Pump (check one): New □ Register Unit and Multiplier Fact Image: Static Water Level (A):	Daired Replacement Power Type (check or al Gas Tractor PTO Windmil Setting Depth: 70 Pump Test Data for Non Flow Duration et Below Land Surface Pump Test Data for Pumping Feet Below Land Surface Test Steel tape Electric tape Air liit Pump Test Data for Flowing Feet drawdown of Meter Installation Meter installed by: Type poaired Replacement information you are certifying that tural wells, a list of approved meter	II Other (descrifeet feet owing Well of Pump Test (m g Water Level (B): Pumping Rate: ne Other (desc ing Well feet after feet after r Serial Number: be of Meter: t this meter was in rs is on the MDE	Number of	urs): Hours Feet Below Land Surface Gallons Per Minute

JUL 1 3 2016 By OLWR

¢.,