

STATE WELL REPORT

Part 1

Driller's Log

Mississippi Department of Environmental Quality
Office of Land and Water Resources
P.O. Box 2309
Jackson, MS 39225-2309
(601)961-5210
(601)360-0535 (fax)

County: Bolivar
Permit #: MS-GW-49748
Driller: Tommy Peacock Sr
Date drilling completed: 11-19-16

For Office Use Only:

Well #: C205
Aquifer: _____
E-Log #: _____

State Law requires that this report be prepared by the license holder responsible for the work and filed with the Department at the above address within 30 days of completion of drilling of the well or borehole.

<p style="text-align: center;">Well Owner Information (Landowner if borehole is not for a water well)</p> <p>Owner Name: <u>K+G Farms - Non Shelby</u> Mailing Address: <u>P.O. Box 26</u></p> <hr/> <p><u>Shelby</u> <u>MS</u> <u>38774</u> City State Zip Code</p> <p>Telephone No. () _____</p>	<p style="text-align: center;">Well or Borehole Location</p> <p>Latitude: <u>33° 58' 38"</u> Longitude: <u>90° 52' 41"</u></p> <p>Method of Lat/ Long (check one): Conventional Survey _____ USGS quad _____, Hand-held GPS <input checked="" type="checkbox"/>, Survey-grade GPS _____</p> <p><u>SE 1/4 NW 1/4, Sec 21 T24N R07W</u></p> <p><u>5</u> Miles <u>W</u> of <u>Shelby</u> (Distance) (Direction) (Nearest Town)</p>
--	---

Well / Borehole Data

Date drilling started: 11-19-16 Date drilling completed: 11-19-16 Hole depth: 115' Hole diameter: 24"

Location of the source of any surface water used for drilling: nearby ditch

Method of dosing and volume of Chlorine used in drilling and development: When Filling tank

Logs run (circle all applicable): No log run Electric Gamma Ray Density Sonic Neutron Other: _____

Name of organization running log(s): _____

Purpose of borehole (circle one): Water Well Geotechnical/ Geological Investigation Ground Source Heat Pump
Seismic Survey Other (describe) _____

If drilling is not related to water well construction, skip the remainder of this block

Purpose of Well (circle all applicable): Home Industrial Public Supply Irrigation Fish Culture

Other (describe): _____

If a flowing well, method of flow regulation: Valve _____ Other (describe) _____

Static Water Level: 38 feet [above or below] land surface Date measured: 11-19-16
(circle one)

Method of measurement (circle one): Steel tape Electric tape Air line Other (describe): _____

Well depth: 115' Well grouted to a depth of: 10 feet Type of grout (circle one): Neat Cement Bentonite Mix

Casing length: 75 feet Casing diameter: 16 inches Type of casing: PVC

Screen length: 40 feet Screen diameter: 16 inches Type of screen: PVC

Screen slot size: 1-032 inches Setting depth: From 75 feet to 115 feet

Type of completion (circle all applicable): Gravel packed Underreamed Open hole Natural Development

Other (describe): _____

Top of lap pipe or reduction in casing: _____ feet

If telescoped or more than one screen, describe on next page

RECEIVED

Form: OLWR-SWR-1A (4/13)

NOV 30 2016

BY OLWR

1. The first part of the document discusses the importance of maintaining accurate records of all transactions. It emphasizes that this is crucial for the company's financial health and for providing reliable information to stakeholders.

2. The second part of the document outlines the specific procedures for recording transactions. It details the steps from identifying a transaction to entering it into the accounting system, ensuring that all necessary details are captured.

3. The third part of the document discusses the role of the accounting department in monitoring and controlling the company's financial performance. It highlights the importance of regular reviews and the use of financial ratios to assess the company's position.

4. The fourth part of the document addresses the challenges of managing financial data in a complex and rapidly changing business environment. It suggests strategies for staying up-to-date and adapting to new requirements.

5. The fifth part of the document discusses the importance of transparency and communication in financial reporting. It stresses the need for clear and concise reports that provide a comprehensive view of the company's financial situation.

6. The sixth part of the document outlines the role of the accounting department in supporting the company's strategic goals. It emphasizes the importance of providing timely and accurate information to management for decision-making.

7. The seventh part of the document discusses the importance of maintaining high standards of ethical conduct in the accounting profession. It highlights the need for integrity and objectivity in all financial reporting.


1950-1951

1952-1953

1954-1955

1956-1957

1958-1959

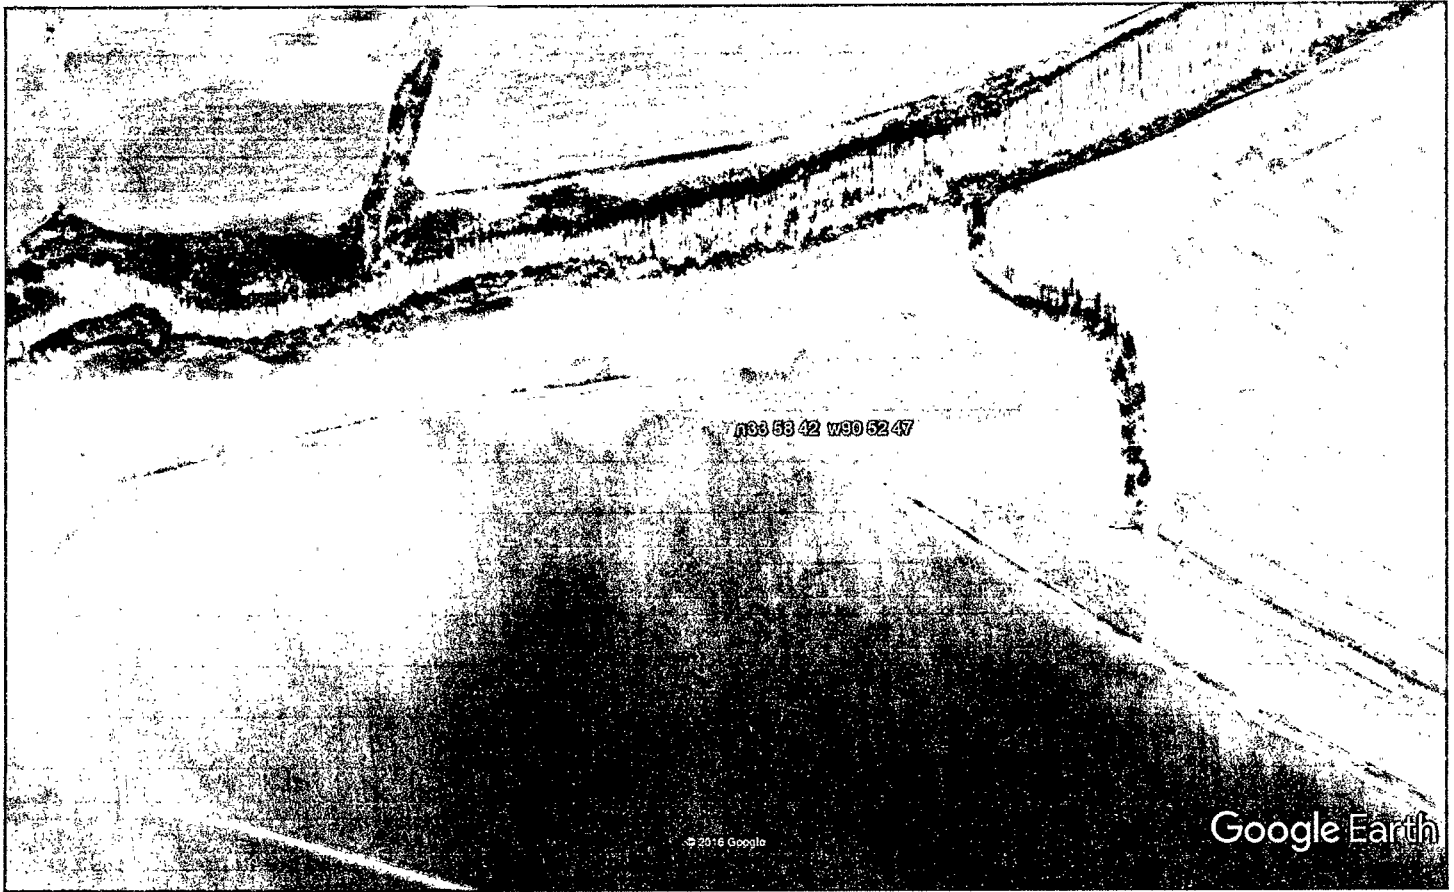

Google Earth



RECEIVED

NOV 30 2016

BY OLWR

STATE WELL REPORT

Part 2

Pump Installer's Completion Report
 Mississippi Department of Environmental Quality
 Office of Land and Water Resources
 P.O. Box 2309
 Jackson, MS 39225-2309
 (601)961-5210
 (601) 360-0535 (fax)

For Office Use Only:

Well #: _____

Aquifer: _____

County: BOLEVADE
 Permit #: GW-49748
 Driller: Tommy Psaceck Sr
 Date completed: 11-19-16
 Copy information from block on Part 1

This part of the report must be completed by a licensed water well contractor, or a licensed pump installer. A copy of Part 1 of the report must be attached and both parts filed with the Department at the above address within 30 days of well completion.

Well Owner Information	Well Location
Owner Name: <u>K and G Farms</u>	Latitude: <u>33° 58' 38"</u> Longitude: <u>90° 52' 41"</u>
Mailing Address: <u>P.O. BOX 26</u>	Method of Lat/Long (check one): Conventional Survey _____, USGS quad _____, Hand-held GPS _____, Survey-grade GPS _____
City: <u>Shelby</u> State: <u>ms</u> Zip Code: <u>38774</u>	<u>SE</u> ¼ <u>NW</u> ¼, Sec. <u>01</u> T. <u>24N</u> R. <u>09W</u>
Telephone No. <u>(662) 398-5121</u>	<u>1.8</u> Miles <u>E</u> of <u>PERTUISHERE</u> (Distance) (Direction) (Nearest Town)

Pump Type (circle one)

Submersible Turbine Air Lift Centrifugal Flowing Well Jet Piston Rotary Other (describe): _____

Date Pump Installed: 11-22-16 Rated Pump Capacity: 3000 Gallons Per Minute

Is This Pump (circle one): New Repaired Replacement

Power Type (circle one)

Electric Diesel Gasoline Natural Gas Tractor PTO Windmill Other (describe): _____

Horse Power Rating of Motor: 80 Setting Depth: 70 feet Number of Stages: 1

Pump Test Data for Non Flowing Well

Date Well Tested: _____ Duration of Pump Test (minimum 4 hours): _____ hours

Static Water Level (A): 38 Feet Below Land Surface Pumping Water Level (B): _____ Feet Below Land Surface

Drawdown [(B) - (A)]: _____ Feet Below Land Surface Test Pumping Rate: _____ Gallons Per Minute

Method of measurement (circle one): Steel tape Electric tape Air line Other (describe): _____

Pump Test Data for Flowing Well

Measured shut in head: _____ feet.

Well yielded _____ GPM with a drawdown of _____ feet after _____ hours of pumping

Meter Installation

Meter Manufacturer: McCrometer Meter Serial Number: 1613458

Meter Model Number/Name: M0310 Type of Meter: GROUND WATER

Totalizer Register Unit and Multiplier Factor (AF x .001, gal x 1000, etc): _____

Installation Date: 11-22-16 Meter installed by: CIRCLE S IRRIGATION

Is This Meter (circle one): New Repaired Replacement

Important: By submitting the above information you are certifying that this meter was installed to manufacturer standards. For agricultural wells, a list of approved meters is on the MDEQ website.

RECEIVED

I HEREBY CERTIFY that the above statements are true to the best of my knowledge.

DAVID P. HOLT 0-752P 11-30-16 [Signature] DEC 15 2016

Print Name of Pump Installer and License No. (if applicable) Date Signature of Pump Installer **BY OLWR**

16-1100