

# STATE WELL REPORT

## Part 1

### Driller's Log

Mississippi Department of Environmental Quality  
 Office of Land and Water Resources  
 P.O. Box 2309  
 Jackson, MS 39225-2309  
 (601)961-5210  
 (601)360-0535 (fax)

#### For Office Use Only:

Well #: C-206  
 Aquifer: \_\_\_\_\_  
 E-Log #: \_\_\_\_\_

County: Bolivar  
 Permit #: MS-GW-49787  
 Driller: Tommy Proctor Sr  
 Date drilling completed: 11-25-14

State Law requires that this report be prepared by the license holder responsible for the work and filed with the Department at the above address within 30 days of completion of drilling of the well or borehole.

<b>Well Owner Information</b> (Landowner if borehole is not for a water well) Owner Name: <u>Hamp Bass</u> Mailing Address: <u>7 Cypress Rd.</u> <u>Clarksdale</u> <u>MS</u> <u>38614</u> City State Zip Code Telephone No. ( ) _____		<b>Well or Borehole Location</b> Latitude: <u>N33° 56' 53"</u> Longitude: <u>W90° 52' 38"</u> Method of Lat/ Long (check one): Conventional Survey _____ USGS quad _____ Hand-held GPS <input checked="" type="checkbox"/> Survey-grade GPS _____ <u>SE 1/4 NW 1/4 Sec 12 T24N R07W</u> <u>4</u> Miles <u>NE</u> of <u>Gunnison</u> (Distance) (Direction) (Nearest Town)	
---	--	---	--

**Well / Borehole Data**

Date drilling started: 11-25-14 Date drilling completed: 11-25-14 Hole depth: 124' Hole diameter: 24"

Location of the source of any surface water used for drilling: existing old well

Method of dosing and volume of Chlorine used in drilling and development: Went filling pit

Logs run (circle all applicable):  No log run  Electric  Gamma Ray  Density  Sonic  Neutron  Other: \_\_\_\_\_

Name of organization running log(s): \_\_\_\_\_

Purpose of borehole (circle one):  Water Well  Geotechnical/ Geological Investigation  Ground Source Heat Pump  
 Seismic Survey  Other (describe) \_\_\_\_\_

If drilling is not related to water well construction, skip the remainder of this block

Purpose of Well (circle all applicable): Home Industrial Public Supply  Irrigation  Fish Culture

Other (describe): \_\_\_\_\_

If a flowing well, method of flow regulation: Valve \_\_\_\_\_ Other (describe) \_\_\_\_\_

Static Water Level: 3 1/2' feet [above or  below] land surface Date measured: 11-25-14  
 (circle one)

Method of measurement (circle one):  Steel tape  Electric tape  Air line Other (describe): \_\_\_\_\_

Well depth: 124' Well grouted to a depth of: 10 feet Type of grout (circle one): Neat Cement  Bentonite  Mix

Casing length: 84 feet Casing diameter: 16 inches Type of casing: PVC

Screen length: 40 feet Screen diameter: 16 inches Type of screen: PVC

Screen slot size: 1.050 1-0.022 inches Setting depth: From 84 feet to 124 feet

Type of completion (circle all applicable):  Gravel packed  Underreamed  Open hole  Natural Development

Other (describe): \_\_\_\_\_


Top of lap pipe or reduction in casing: \_\_\_\_\_ feet

If telescoped or more than one screen, describe on next page


RECEIVED  
 Form: OLWR-SWR-1A(4/13)

DEC 05 2016  
 BY OLWR



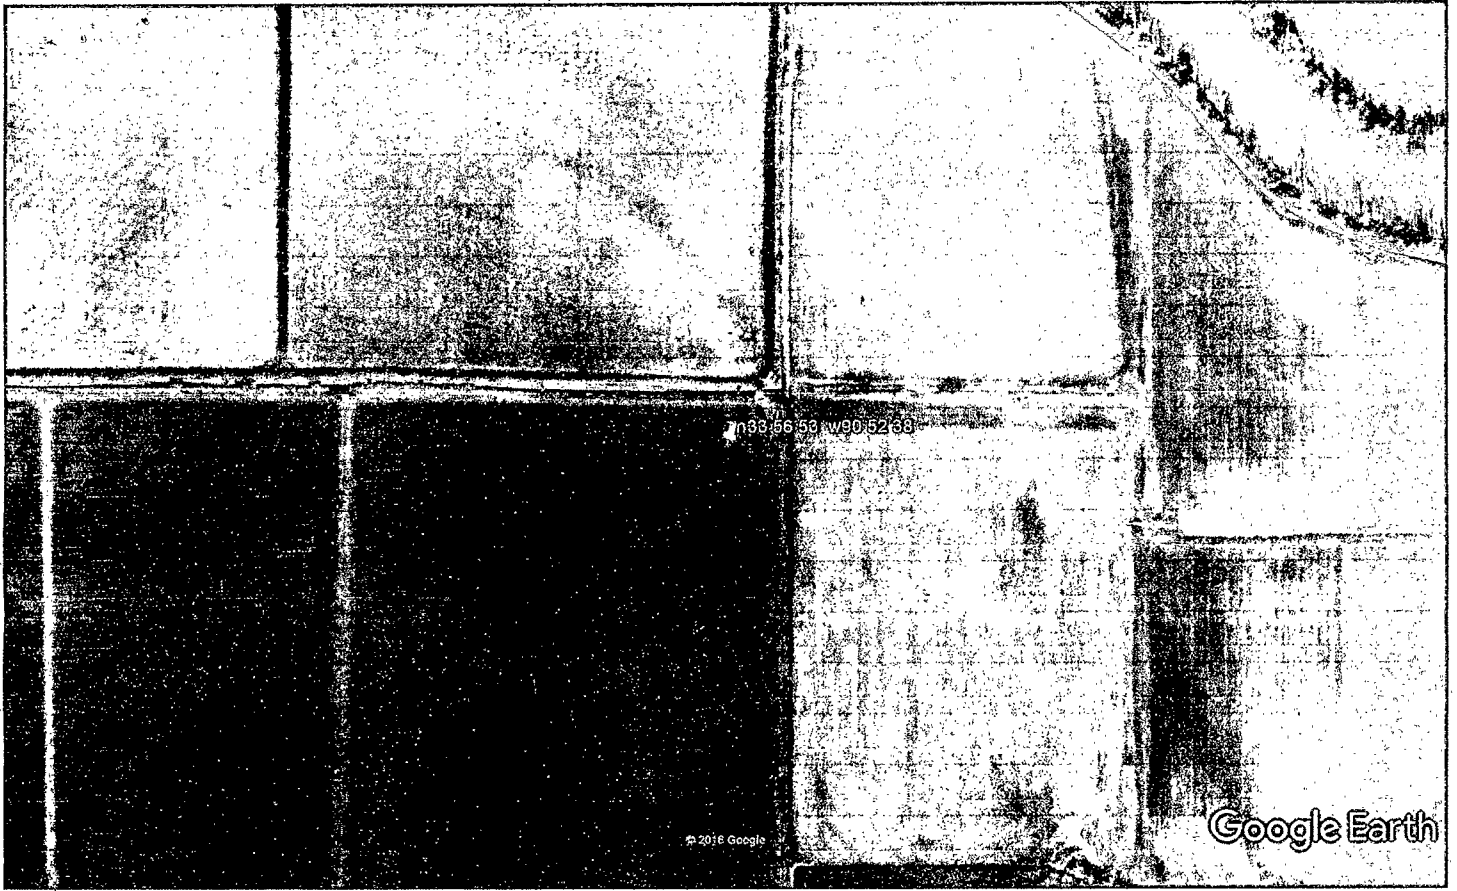

Google Earth

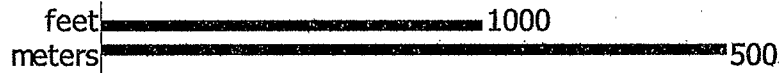

RECEIVED  
DEC 05 2016  
BY OLWR