

BOLIVAR MISSISSIPPI BOARD OF WATER COMMISSIONERS

C-1001
10-15-64

WATER WELL DRILLERS LOG


Date: 10-15, 1964, Driller: Frank Taylor County Denala
(Name)

(1) Owner of Land:	Description & Color of Materials Sand, Clay, Red Clay, Shell, etc.	Thick- ness Feet	Depth Feet
<u>Rufus Simler</u> (Name) <u>Garrison, Miss</u> (Address)	Clay	0	100
(2) Location: <u>1/4</u> , <u>1/4</u> , Sec. <u>T</u> <u>R</u>	Gravel	100	150
_____ miles _____ of _____ (distance) (direction) (Nearest Town)	Clay	150	400
(3) Topography: <u>Flat</u>	Washed	400	442
(4) Purpose of Well: <u>Dom.</u> (Domestic Irrigation Municipal, Industrial, Other)			

Information upon completion of well:

- (1) Diameter 2 inches.
- (2) Total Depth 451 feet.
- (3) Water Level 40 feet below top of ground.
- (4) Cased to 442, Size 2"
- (5) Screen: Size 1/4, Length 6'
- (6) Were any formations sealed against pollution?
_____ yes, _____ no.

If YES depth of formation _____
Why _____
Drillers Remarks: _____

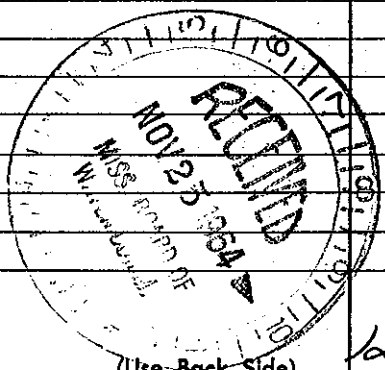

Well No. 12

Mail this copy to Board of Water Commissioners 429 Miss. St. Jackson, Miss.