

Bolivar

C-1005  
2-66

MISSISSIPPI BOARD OF WATER COMMISSIONERS

WATER WELL DRILLERS LOG

4/1/66  
me 2129

Date: Feb. 11, 19 66, Driller: Layne-Central Company County Bolivar

(Name)

(1) Owner of Land: Merchants Plantation (Name)	Description & Color of Materials Sand, Clay, Red Clay, Shell, etc.	Thick- ness Feet	Depth Feet
Gunnison, Mississippi (Address)	Top soil	6	6
(2) Location: 1/4, 1/4, Sec. T. R.	Clay balls	37	43
miles, of Gunnison (distance) (direction) (Nearest Town)	Fine sand	7	50
(3) Topography: flat (Hilly) (Flat) (Level)	Coarse sand	25	75
(4) Purpose of Well: irrigation (Domestic Irrigation Municipal, Industrial, Other)	Coarse sand and pea gravel	33	108
	Coarse sand, pea gravel and boulders	14	122


Information upon completion of well:

- (1) Diameter 16 inches.
- (2) Total Depth 122 feet.
- (3) Water Level 16' 8" feet below top of ground.
- (4) Cased to 72', Size 16"
- (5) Screen: Size 16", Length 50'
- (6) Were any formations sealed against pollution?  
yes, no no.

If YES depth of formation

Why

Drillers Remarks:

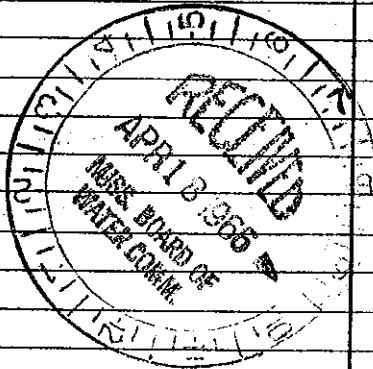

Well No.

(Use Back Side)

Mail this copy to Board of Water Commissioners 429 Miss. St. Jackson, Miss