

BOLIVAR

MISSISSIPPI BOARD OF WATER COMMISSIONERS

9/24/65  
418

C-1007  
5-14-57

WATER WELL DRILLERS LOG

Date: May 14, 1957, Driller: Layne-Central Company County Bolivar

(Name)

(1) Owner of Land: Sidney Levingston  
(Name)  
Ruleville, Mississippi  
(Address)

(2) Location: 1/4, 1/4, Sec. T R  
2 miles west of Perthshire  
(distance) (direction) (Nearest Town)

(3) Topography: flat  
(Hilly) (Flat) (Level)

(4) Purpose of Well: irrigation  
(Domestic Irrigation  
Municipal, Industrial, Other)

Description & Color of Materials Sand, Clay, Red Clay, Shell, etc.	Thick- ness Feet	Depth Feet
Top soil	7	7
Clay	19	26
Coarse blue sand & clay balls	6	32
Coarse sand	10	42
Coarse sand	10	52
Coarse sand & pea rock	10	62
Coarse sand, pea rock & lignite	10	72
Coarse sand	10	82
Coarse sand & lignite	10	92
Sand & gravel	10	102
Sand & gravel	10	112

Information upon completion of well:

(1) Diameter 18x12 inches.

(2) Total Depth 112 feet.

(3) Water Level 9'10" feet below top of ground.

(4) Cased to 57', Size 18"  
5' of 18" x 12" swage

(5) Screen: Size 50', Length 12"

(6) Were any formations sealed against pollution?  
no yes, no no.


If YES depth of formation \_\_\_\_\_

Why \_\_\_\_\_

Drillers Remarks: \_\_\_\_\_

2409 GPM.

Engine drive.

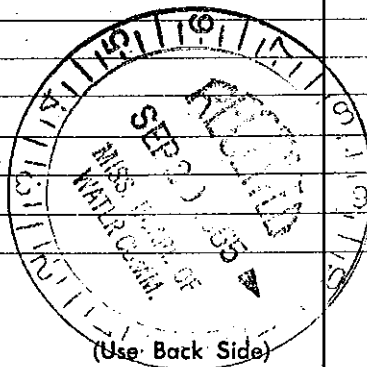

Well No. \_\_\_\_\_

Mail this copy to Board of Water Commissioners 429 Miss. St. Jackson, Miss