

MISSISSIPPI DEPARTMENT OF ENVIRONMENTAL QUALITY

Office of Land and Water Resources

P. O. Box 10631
Jackson, MS 39289-0631
WATER WELL DRILLERS LOG

COUNTY WELL LOCATED Bolivar	
WELL NUMBER C 2008	CODED
DATE WELL COMPLETED 10-25-95	

PERMIT NUMBER
NAME OF DRILLING FIRM Irrigation Equipment
INDianola, MS

NAME & MAILING ADDRESS OF LANDOWNER		
C.T. Danna		
Conservation Lake Rd.		
Rosedale, MS 38769		
WELL LOCATION: SEC	TOWNSHIP	RANGE
SW/SE 32	24N S	7W E W
DISTANCE	DIRECTION	NEAREST TOWN
5 Miles	NE	Rosedale
OTHER LANDMARK		
WELL PURPOSE: Home, Irrigation, Municipal, Industrial, Fish Pond, etc. Irrigation Pivot		

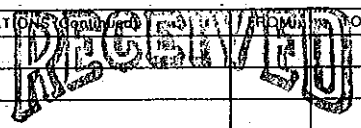
PUMP DATA		
PUMP TYPE (Circle One): Submersible, Turbine , Jet, Flowing Well, Other (Describe)		
POWER TYPE (Circle One): Electric, Tractor, Diesel , Gasoline, Butane, Other (Describe) H/P 80		
Pump Capacity (GPM)	No. of Stages	Setting Depth
1400	3	50 FT.
PUMP TEST		
Well yielded _____ GPM with a drawdown of _____ ft. after _____ hours of pumping		

WELL DATA		
Well Depth	Casing Diameter (In.)	Casing Length (Ft.)
92	16	52
Type of Casing	Hole Depth	Depth to Static Water Level
Steel	92	26 ft.
TYPE OF COMPLETION: (Circle One or More): Gravel Packed , Underreamed, Telescoped, Natural Development, Open Hole, Other (Describe)		
WELL GROUTED TO A DEPTH OF _____ FEET Type Grout (circle one): Cement, Bentonite, or Mix		

LOG DATA	
TYPE OF LOG RUN (Circle One): No Log Run, Electric, Gamma Ray, Density, Sonic, Neutron, Other (Describe)	
Name of Organization Running Log	

SCREEN DATA		
Diameter - Inches	Length - Feet	Slot Size - Inches
16	40	.060
Screen Type	Depth to Bottom - Feet	
Steel	92	

GEOLOGIC DATA (Office Use Only)			
Surface Elev.	Geologic Unit	Unit Thickness	Depth to Top
Subs. SWL	Date	Analysis	Aquifer Test
Driller's Remarks			
Top of Lap Pipe or Reduction in Casing			
FEET			
IF TELESCOPED OR MORE THAN ONE SCREEN: USE BACK PAGE			

DESCRIPTION OF FORMATIONS ENCOUNTERED	FROM	TO	FORMAT
Clay	0	15	 DEC 19 1995 Dept. of Environmental Quality Office of Land & Water Resources
Fine Sand	15	35	
Fine Sand & Gravel	35	40	
Med. Sand & Gravel	40	92	

IF MORE SPACE IS NEEDED, USE BACK