

**BOLIVAR** MISSISSIPPI BOARD OF WATER COMMISSIONERS

**D 36**

**1-22-62**

**WATER WELL DRILLERS LOG**

*Code*

*C-221R  
P-300*

Date: Jan. 22, 19 62, Driller: Layne-Central Company County Bolivar

(Name)

(1) Owner of Land: City of Shelby  
(Name)

Country Club, Shelby, Mississippi  
(Address)

(2) Location: 1/4, 1/4, Sec. 14 T. R 6W  
1 1/2 miles southwest, of Shelby  
(distance) (direction) (Nearest Town)

(3) Topography: flat  
(Hilly) (Flat) (Level)

(4) Purpose of Well: Municipal  
(Domestic Irrigation  
Municipal, Industrial, Other)

Description & Color of Materials Sand, Clay, Red Clay, Shell, etc.	Thick- ness Feet	Depth Feet
Clay	17	17
Sandy clay	13	30
Fine sand	35	65
Coarse sand	10	75
Coarse sand & pea gravel	50	125
Clay	23	148
Clay & sandy clay strks.	64	212
Fine sand	18	230
Hard clay	49	279
Clay & sandy clay strks.	12	291
Sand	60	351
Clay	12	363
Sand	58	421
Sand rock	2	423
Hard shale	24	447
Sandy shale	51	498
Fine sand	19	517
Shale	29	546
Hard Clay	73	619
Rock	1	620
Hard clay	57	677
Rock	1	678
Clay	34	712
Sandy shale	9	721
Fine sand	15	736
Clay	5	741
Sand	62	803

Information upon completion of well:

(1) Diameter 4 inches.

(2) Total Depth 805 feet.

(3) Water Level 22' - 4" feet below top of ground.

(4) Cased to 762', Size 4"


(5) Screen: Size 4", length 40'  
3' x 4" B.P.V.

(6) Were any formations sealed against pollution?  
yes yes, no no.

If YES depth of formation Packer above the screen.

Why \_\_\_\_\_

Drillers Remarks: \_\_\_\_\_

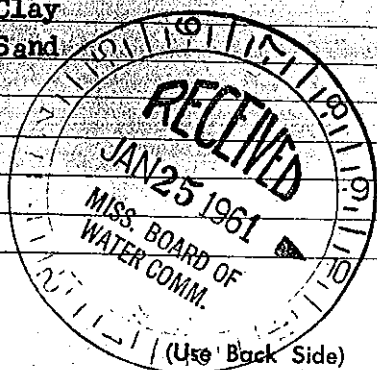

Well No.

Mail this copy to Board of Water Commissioners 429 Miss. St. Jackson, Miss.