

BOLIVAR

D-38

MISSISSIPPI BOARD OF WATER COMMISSIONERS

1-15-57

WATER WELL DRILLERS LOG

0327

Date: Jan. 15, 1957, Driller: Layne-Central Company

(Name)

CODED

(1) Owner of Land: George Shelby
(Name)
Shelby, Mississippi
(Address)

(2) Location: 1/4, 1/4, Sec. 15, T24R6
3 miles west of Shelby
(distance) (direction) (Nearest Town)

(3) Topography: flat
(Hilly) (Flat) (Level)

(4) Purpose of Well: irrigation
(Domestic Irrigation
Municipal, Industrial, Other)

Description & Color of Materials Sand, Clay, Red Clay, Shell, etc.	Thick- ness Feet	Depth Feet
Top sandy soil	7	7
Blue clay	32	38
Coarse sand & clay balls	4	42
Coarse sand	20	62
Sand, pea gravel & lignite	20	82
Sand & gravel	22	104
Gravel & fine sand	2	106

Information upon completion of well:

(1) Diameter 18x12 inches.

(2) Total Depth 108 feet.


(3) Water Level 20'-5" feet below top of ground.

(4) Cased to 54' Size 18"
2' swage

(5) Screen: Size 12" Length 50'

(6) Were any formations sealed against pollution?
no yes, no no.

CODED

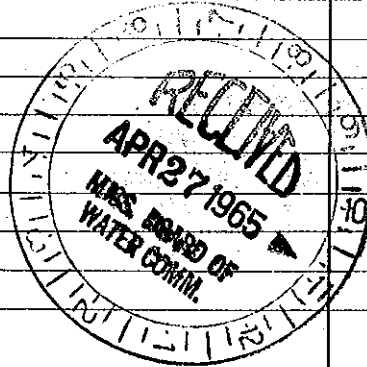

If YES depth of formation _____

Why _____

Drillers Remarks: _____
2409 GPM
engine drive

Well No.

(Use Back Side)

ail this copy to Board of Water Commissioners 429 Miss. St. Jackson, Miss