

BOLIVAR MISSISSIPPI BOARD OF WATER COMMISSIONERS

D-39

1-23-57 WATER WELL DRILLERS LOG

CODED *C357*

Date: Jan. 23, 1957, Driller: Layne-Central Company County Bolivar

(Name)

(1) Owner of Land: <u>Allendale Planting</u> (Name)	Description & Color of Materials Sand, Clay, Red Clay, Shell, etc.	Thick- ness Feet	Depth Feet
<u>Shelby, Mississippi</u> (Address)	<u>Top sandy soil</u>	<u>5</u>	<u>5</u>
(2) Location: <u>N 1/4</u> , <u>1/4</u> , Sec. <u>12-24-6</u> <u>2</u> miles <u>north</u> of <u>Shelby</u> (distance) (direction) (Nearest Town)	<u>Blue clay</u>	<u>14</u>	<u>19</u>
(3) Topography: <u>flat</u> (Hilly) (Flat) (Level)	<u>Coarse brown sand</u>	<u>16</u>	<u>35</u>
(4) Purpose of Well: <u>irrigation</u> (Domestic Irrigation Municipal, Industrial, Other)	<u>Coarse blue sand</u>	<u>7</u>	<u>42</u>
	<u>Coarse sand</u>	<u>10</u>	<u>52</u>
	<u>Coarse sand & pea gravel</u>	<u>30</u>	<u>82</u>
	<u>Sand & pea gravel</u>	<u>10</u>	<u>92</u>
	<u>Sand & big gravel</u>	<u>10</u>	<u>102</u>
	<u>Sand & gravel</u>	<u>10</u>	<u>112</u>

Information upon completion of well:

- (1) Diameter 18x12 inches.
- (2) Total Depth 112 feet.
- (3) Water Level 25 feet below top of ground.
- (4) Cased to 57', Size 18"
5' swage
- (5) Screen: Size 12", Length 50'
- (6) Were any formations sealed against pollution?
no yes, no no.

If YES depth of formation _____

Why _____


Drillers Remarks: _____

2000 GPM

engine drive

Mail this copy
tain this copy for your office files.

CODED

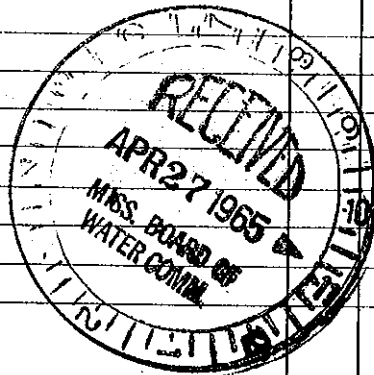

(Use Back Side)

Well No. _____