

**BOLIVAR**

**MISSISSIPPI BOARD OF WATER COMMISSIONERS**

**D-41**

**2-7-57 WATER WELL DRILLERS LOG**

**CODED 1357**

Date: Feb. 7, 1957, Driller: Layne-Central Company County Jackson

(Name)

(1) Owner of Land:	Company	Description & Color of Materials	Thick-ness Feet	Depth Feet
<u>Allendale Planting</u>		<u>Clay</u>	<u>27</u>	<u>27</u>
(Name)		<u>Fine blue sand</u>	<u>15</u>	<u>42</u>
<u>Shelby, Mississippi</u>		<u>Coarse sand &amp; pea gravel</u>	<u>10</u>	<u>52</u>
(Address)		<u>Coarse sand</u>	<u>10</u>	<u>62</u>
(2) Location: $\frac{1}{4}$ , $\frac{1}{4}$ , Sec. <u>2</u> <sup><u>24 N 6 W</u></sup> T R		<u>Sand &amp; gravel</u>	<u>20</u>	<u>82</u>
<u>3</u> miles <u>northwest</u> of <u>Shelby</u>		<u>Sand &amp; pea gravel &amp; big</u>		
(distance) (direction) (Nearest Town)		<u>gravel</u>	<u>20</u>	<u>102</u>
(3) Topography: <u>flat</u>		<u>Sand &amp; gravel</u>	<u>10</u>	<u>112</u>
(Hilly) (Flat) (Level)				
(4) Purpose of Well: <u>irrigation</u>				
(Domestic Irrigation, Municipal, Industrial, Other)				

Information upon completion of well:

- (1) Diameter 18x12 inches.
- (2) Total Depth 112' feet.
- (3) Water Level 23' - 4" feet below top of ground.
- (4) Cased to 57', Size 18"  
5' swage
- (5) Screen: Size 12", Length 50'
- (6) Were any formations sealed against pollution?  
no yes, no no.


If YES depth of formation \_\_\_\_\_

Why \_\_\_\_\_

Drillers Remarks:

2000 GPM

engine drive

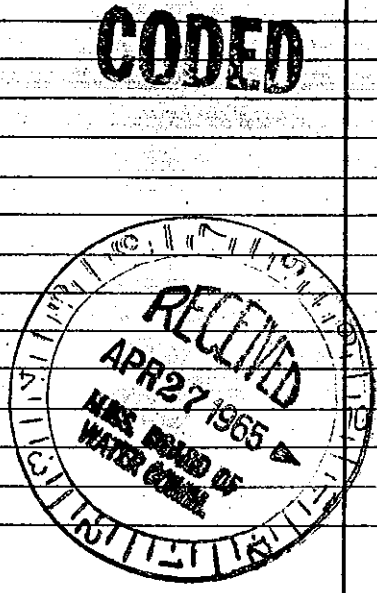

(Use Back Side)

Well No.

ail this copy to Board of Water Commissioners 429 Miss. St. Jackson, Miss