

BOLIVAR

D-42

3-15-57

MISSISSIPPI BOARD OF WATER COMMISSIONERS

WATER WELL DRILLERS LOG

Date: March 15, 1957, Driller: Layne-Central Company

9/17/65

380
CODED

(1) Owner of Land: Denton Manufacturing Co. (Name)

Shelby, Mississippi (Address)

Description & Color of Materials
Sand, Clay, Red Clay, Shell, etc.

Thickness Feet	Depth Feet
23	23
31	54
19	73
39	112

(2) Location: 1/4, 1/4, Sec. 28 T24R6

3 miles west of Shelby (distance) (direction) (Nearest Town)

Clay
Fine sand
Coarse sand
Coarse sand, gravel

(3) Topography: flat (Hilly) (Flat) (Level)

(4) Purpose of Well: irrigation (Domestic Irrigation Municipal, Industrial, Other)

Mftg

Information upon completion of well:

(1) Diameter 12 inches.

(2) Total Depth 112 feet.

(3) Water Level 22' 5" feet below top of ground.

(4) Cased to 62', Size 12"

(5) Screen: Size 12", Length 50'

CODED


Were any formations sealed against pollution?
yes, no no.

5 depth of formation

Remarks:

0 GPM.

ne Drive.

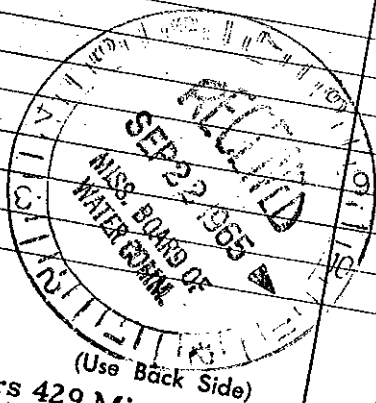

Well No.

copy to Board of Water Commissioners 429 Miss. St. Jackson, Miss