

3010101

MISSISSIPPI BOARD OF WATER COMMISSIONERS

D 51  
9-66

CODED

WATER WELL DRILLERS LOG

CODED

Date: 9-29, 1966, Driller: Fish Lake Farmers Co. Bolivar  
(Name)

(1) Owner of Land: Jack H. Wilkinson  
(Name)  
Shelby, Miss RFD.  
(Address)

(2) Location: SW 1/4, SW 1/4, Sec. 15 T24N R6W  
2 miles SW of Shelby  
(distance) (direction) (Nearest Town)

(3) Topography: Flat  
(Hilly) (Flat) (Level)

(4) Purpose of Well: Fish Lake Irrigation  
(Domestic Irrigation  
Municipal, Industrial, Other)

Description & Color of Materials Sand, Clay, Red Clay, Shell, etc.	Thick- ness Feet	Depth Feet
<u>Topsoil &amp; Clay</u>		<u>40'</u>
<u>Fine Sand</u>	<u>6 1/2</u>	<u>46 1/2</u>
<u>Blue Clay</u>	<u>6 1/2</u>	<u>53</u>
<u>Clay &amp; Sand</u>	<u>6 1/2</u>	<u>59 1/2</u>
<u>Sand &amp; Gravel</u>	<u>19 1/2</u>	<u>79</u>
<u>Coarse Sand, Gravel</u>		
<u>+ large rocks</u>	<u>52</u>	<u>131</u>

Information upon completion of well:

(1) Diameter 6" inches.

(2) Total Depth 129' feet.

(3) Water Level 20' feet below top of ground.

(4) Cased to 81', Size 6"

(5) Screen: Size 6", Length 48'


(6) Were any formations sealed against pollution?  
 yes,  no.

If YES depth of formation \_\_\_\_\_

Why \_\_\_\_\_

Drillers Remarks: \_\_\_\_\_

CODED

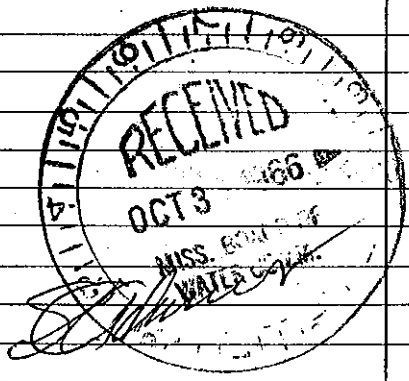

Well No

(Use Back Side)  
 Mail this copy to Board of Water Commissioners 429 Miss. St. Jackson, Miss. 39209