


CODED

CODED

Bolivar
D 52
4-67

MISSISSIPPI BOARD OF WATER COMMISSIONERS
416 North State Street
Jackson, Mississippi 39201
WATER WELL DRILLERS LOG

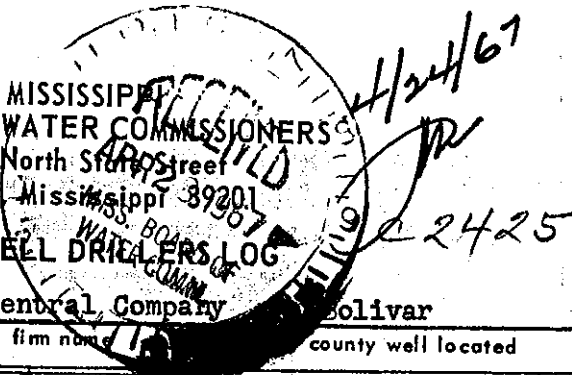

April 9, 1967 Layne-Central Company Bolivar
date well completed firm name county well located

LANDOWNER: Eagle Nest Plantation	Description of formations encountered	from	to
	Clay	0	29
	Sand	29	40
Shelby, Mississippi	Coarse sand	40	69
(mailing address)	Coarse sand & pea gravel	69	82
	Coarse sand & gravel	82	102
WELL LOCATION:			
sec. <u>B</u> T <u>24</u> R <u>6</u> E			
5 miles <u>west</u> south of <u>Shelby</u>			
(distance) (direction) (nearest town)			
WELL PURPOSE: <u>Irrigation</u>			
(home, irrigation, municipal, industrial)			
WELL COMPLETION DATA:			
(1) diameter (inches) <u>10</u>			
(2) total depth (feet) <u>102</u>			
(3) static water level (feet) <u>201.8</u> above top of ground.			
(4) casing <u>steel</u> <u>72'</u>			
(material) (depth)			
<u>10"</u> if telescope see back.			
(size)			
(5) screen <u>30'</u> <u>102'</u>			
(length) (depth to top)			
<u>10"</u> <u>Armco</u>			
(size) (material)			
(6) pump <u>15</u> <u>800</u>			
(HP) (yield gpm)			
<u>tractor PTO</u>			
(type power)			
(7) electric log <u>no</u>			
(yes or no)			
(organization running log)			
(8) how well bottom plugged <u>plate</u>			
DRILLERS REMARKS:			

CODED

