

CODED

CODED

8/14/67
JW
2450

Bolivar
D 53
7-67

MISSISSIPPI
BOARD OF WATER COMMISSIONERS
416 North State Street
Jackson, Mississippi 39201
WATER WELL DRILLERS LOG

July 1, 1967 Layne-Central Company Bolivar
date well completed firm name county well located

LANDOWNER: Mound Bayou Conservation & Recreation League	description of formations encountered	from	to
	Clay	0	14
	Coarse sand	14	35
Mound Bayou, Mississippi (mailing address)	Coarse sand, pea gravel and gravel	35	112


WELL LOCATION:
sec 36-24 N R 6 E
S W Mound Bayou
3 miles west of (distance) (direction) (nearest town)

WELL PURPOSE: Recreational
(home, irrigation, municipal, industrial)

WELL COMPLETION DATA:

- (1) diameter (inches) 12
- (2) total depth (feet) 112
- (3) static water level (feet) 17' 4" below top of ground
- (4) casing steel 72' (material) (depth)
12" (size) If telescope see back.
- (5) screen 40' 112' (length) (depth: to top)
1-2" (size) Armco (material)
- (6) pump 1.5 (HP) 1000 (yield gpm)
electric (type power)
- (7) electric log no (yes or no)
(organization running log)
- (8) how well bottom plugged plate

CODED

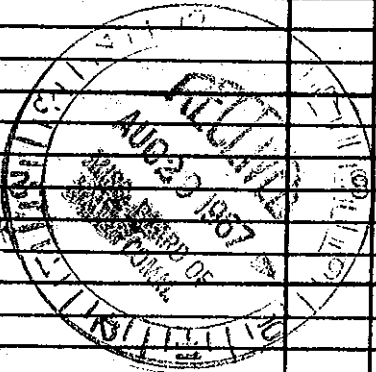

DRILLERS REMARKS: