

C17630

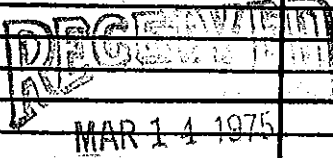
BOLIVAR
D54
3-2-75

MISSISSIPPI
BOARD OF WATER COMMISSIONERS
416 North State Street
Jackson, Mississippi 39201

CODED

WATER WELL DRILLERS LOG

March 2, 1975 Singer-Layne Central Div. Bolivar
date well completed firm name county well located

LANDOWNER:	description of formations encountered	from	to
Hester Farms			
Shelby, Miss. (mailing address)	Fine Sand	15	41
	Coarse Sand	41	66
	Pea Gravel	66	112
WELL LOCATION:			
sec. 3 T. 24 N R. 6 W			
6 miles northwest of Shelby (distance) (direction) (nearest town)			
WELL PURPOSE: Irrigation (home, irrigation, municipal, industrial)			
WELL COMPLETION DATA:			
(1) diameter (inches) 12"			
(2) total depth (feet) 110'			
(3) static water level (feet) 14' below top of ground. at rock			
(4) casing steel, 110' (material) (depth), 12" (size) if telescope see back.			
(5) screen 40' (length), 72' (depth to top), 12" (size), steel (material)			
(6) pump 40 (HP), 1500 (yield gpm) engine (type power)			
(7) electric log no (yes or no)			
(organization running log)			
(8) how well bottom plugged with plate			
DRILLERS REMARKS:			
			
MISS. Bd. OF WATER COMM			