

BOLIVAR

CL-0746 DGI

3-3-78

MISSISSIPPI BOARD OF WATER COMMISSIONERS
416 North State Street
Jackson, Mississippi 39201

CODED

WATER WELL DRILLERS LOG

3-3-78 LAYNE CENTRAL COMPANY BOLIVAR

date well completed firm name county well located

LANDOWNER: Glenn Radicioni

Shelby, MS


(mailing address)

description of formations encountered

from to

Clay	0	38
Fine Sand	38	60
Coarse Sand	60	75
Coarse Sand & Gravel	75	112

WELL LOCATION:

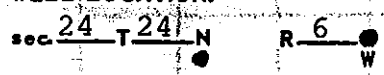

(distance) miles (direction) of (nearest town)

WELL PURPOSE: Irrigation
(home, irrigation, municipal, industrial)

WELL COMPLETION DATA:

(1) diameter (inches) 12"

(2) total depth (feet) 112'

(3) static water level (feet) 29' below top of ground

(4) casing Steel 82'
(material) (depth)

12" If telescope see back.
(size)

(5) screen 30' 82'
(length) (depth to top)

12" St. Steel
(size) (material)

(6) pump 25 1500
(HP) (yield gpm)

electric
(type power)

(7) electric log NO
(yes or no)

(organization running log)

(8) how well bottom plugged St. Plate

DRILLERS REMARKS:

RECEIVED

OCT 5 1978

MISS. BD. OF WATER COMMISSIONERS