

LOCATION BOLLIVAR COUNTY

COMPLETED 6-5-8


ADDRESS SHELBY MISS.

CONTRACT NO. 3317

D-123

FORMATION LOG:

| | | |
|----|-----|-----------------|
| 0 | 19 | CLAY |
| 19 | 35 | SAND |
| 35 | 56 | SAND GRAVEL |
| 56 | 121 | COURSESAND GRAV |
| | | |
| | | |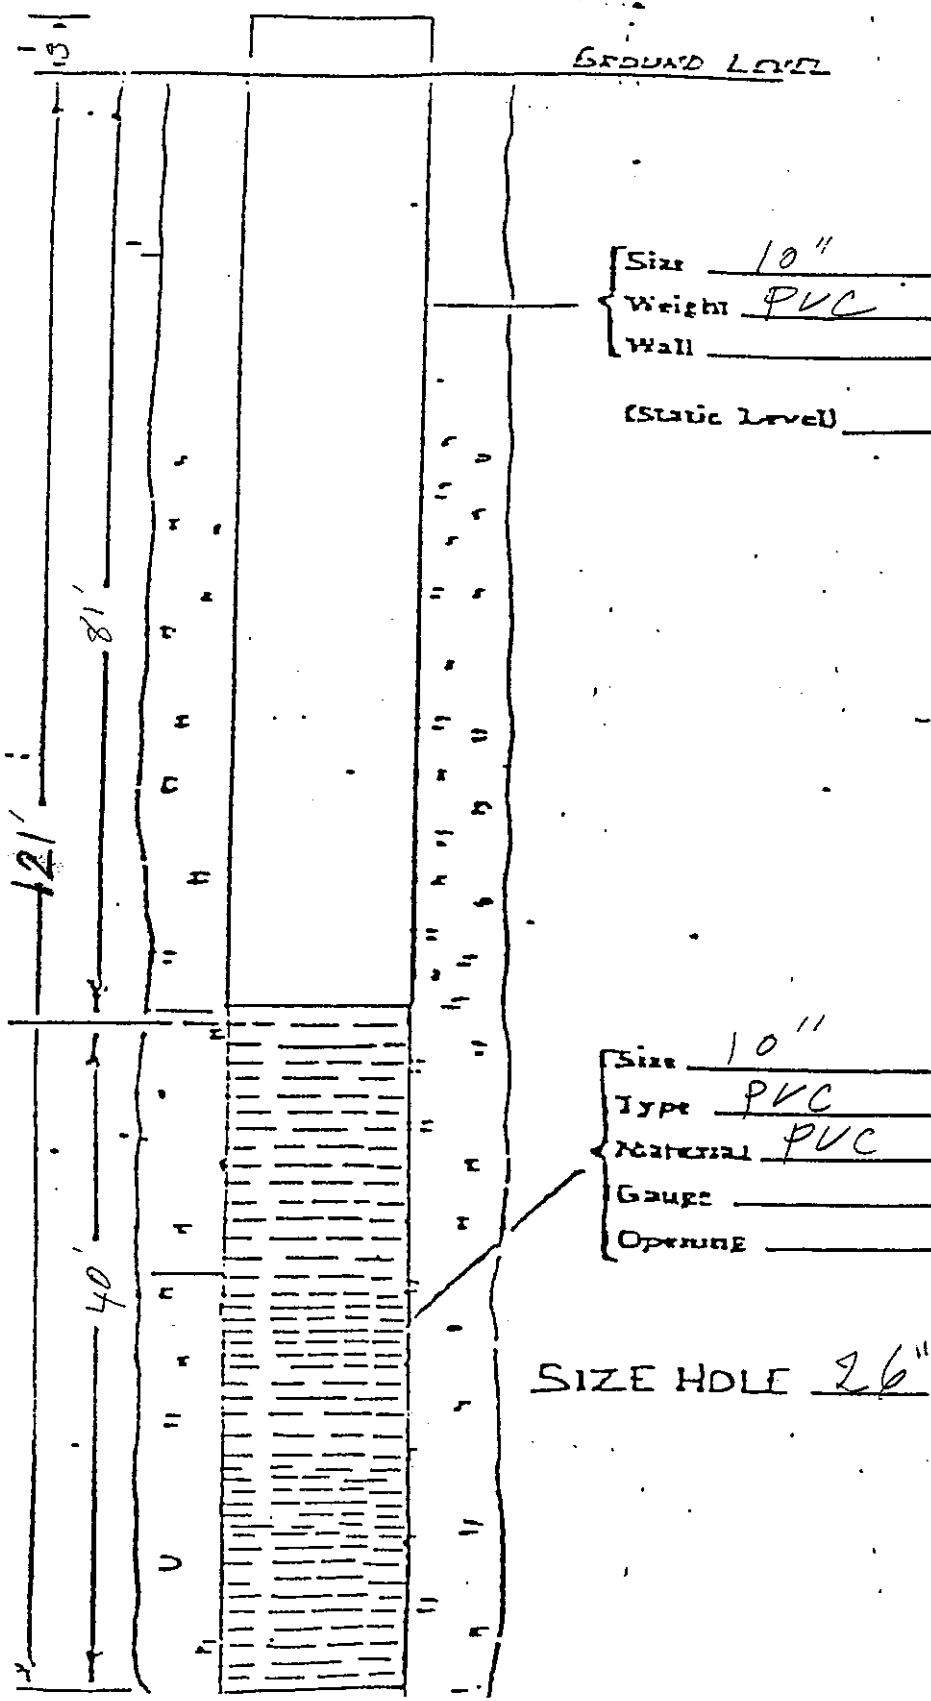
S14 T24N R6W
MSGW 3414

RECEIVED
JAN 29 2003
BY: OLWR

DRILLER: [Signature]
LAYNE-CENTRAL COMPANY
A Div. of Layne-Western Co.