

D-130

New Wells

MISSISSIPPI DEPARTMENT OF ENVIRONMENTAL QUALITY

Office of Land and Water Resources

P.O. Box 10631
Jackson, MS 39289-0631

WATER WELL DRILLERS LOG

COUNTY WELL LOCATED Bolivar	
WELL NUMBER 3	CODED
WELL INFO ONLY	
DATE WELL COMPLETED 4/5/04	

MS-GW-39587

PERMIT NUMBER GW39587
NAME OF DRILLING FIRM Layne-Central, a division of Layne
Christensen Company


NAME & MAILING ADDRESS OF LANDOWNER Ming Planting Company Route 1, Box 466 Shelby, MS 38774			
Latitude: N33°55'23.0" Longitude: W090°48'54.9"			
WELL LOCATION	SEC	TOWNSHIP	RANGE
NW/NW	22	24 <input checked="" type="checkbox"/> N <input type="checkbox"/> S	6 <input type="checkbox"/> E <input checked="" type="checkbox"/> W
DISTANCE 2 Miles	DIRECTION SW	NEAREST TOWN of Shelby, MS	
OTHER LANDMARK			
WELL PURPOSE: Home, Irrigation, Municipal, Industrial, Fish Pond, etc. Irrigation			


PUMP DATA (Pump Not Yet Installed)		
PUMP TYPE (Check One): Installed Customer's Pump <input type="checkbox"/> Submersible <input checked="" type="checkbox"/> Turbine <input type="checkbox"/> Jet <input type="checkbox"/> Flowing Well <input type="checkbox"/> Other (Describe)		
POWER TYPE (Check One): <input type="checkbox"/> Electric <input type="checkbox"/> Tractor <input type="checkbox"/> Diesel <input type="checkbox"/> Gasoline <input type="checkbox"/> Butane <input checked="" type="checkbox"/> Other (Describe) 6.5 Gear DRIVE H/P		
DESCRIPTION OF FORMATIONS ENCOUNTERED	FROM	TO
Top Soil	0	12
Sandy Clay	12	23
Coarse Sand	23	73
Coarse Sand, Gravel	73	130
RECEIVED		
APR 19 2004		
BY: OLWR		
Top of Lap Pipe or Reduction in Casing		
FEET <small>IF TELESCOPED OR MORE THAN ONE SCREEN, USE BACK PAGE</small>		

WELL DATA		
Well Depth 129 ft.	Casing Diameter (in) 16"	Casing Length (Ft.) 79 ft.
Type of Casing PVC	Hose Depth 130 ft.	Depth to Static Water Level 41 ft.
TYPE OF COMPLETION (Check One or More) <input checked="" type="checkbox"/> Gravel Packed <input type="checkbox"/> Underreamed <input type="checkbox"/> Telescoped <input type="checkbox"/> Natural Development <input type="checkbox"/> Open Hole <input type="checkbox"/> Other (Describe)		
WELL GROUTED TO A DEPTH OF 10 FEET Type of Grout (Check One) <input checked="" type="checkbox"/> Cement <input type="checkbox"/> Bentonite or <input type="checkbox"/> Mix		

SCREEN DATA		
Diameter - inches 16"	Length - feet 50 ft.	Slot Size - inches .050
Screen Type PVC	Depth to Bottom - Feet 129 ft.	

I certify that the well was drilled, constructed and completed in accordance with all applicable Requirements of the Mississippi Department of Environmental Quality and/or the Mississippi Department of Health regulations and state laws.

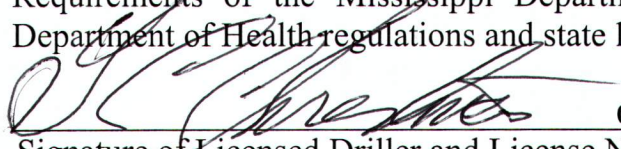 0-64
Signature of Licensed Driller and License No.

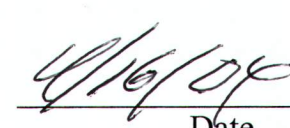
Date

Additional Information Required on Back

If well telescopes, please sketch and show depths.

GROUND LEVEL

SECTION _____

Please indicate well location X.

Pump Capacity (GPM) 2500	No. of Stages n/a	Setting Depth n/a FT.
------------------------------------	-----------------------------	---------------------------------

PUMP TEST

Well yielded NOT TESTED GPM with a drawdown of _____ ft. after _____ hours of pumping

LOG DATA

TYPE OF LOG RUN (Check One): No Log Run
 Electric, Gamma Ray, Density, Sonic, Neutron,
 Other (Describe) _____

Name of Organization Running Log
 N/A

GEOLOGICAL DATA (Office Use Only)

Surface Elev.	Geologic Unit	Unit Thickness	Depth to Top
Subs SWL	Date	Analysis	Aquifer Test

Driller's Remarks
 Layne File No. 22-9246

If more than one screen, show location of each on sketch.

topozone



VIEW MAPS GET DATA MY TOPOZONE WEB SERVICES ABOUT US

33° 55' 23"N, 90° 48' 55"W (WGS84)
USGS **Shelby** Quad

[View TopoZone Pro aerial photos, shaded relief, street maps, interact](#)

- Map/Photo Info
- Topo Download
- Photo Download

USGS Topo Maps

- 1:24K/25K Series
- 1:100K Series
- 1:250K Series

Map Size

- Small
- Medium
- Large

View Scale

1 : 50,000

Update Map

Coordinate Format

D/M/S

Coordinate Datum

WGS84/NAD83

Show target



[Email this map](#)

[Bookmark this map](#)



[Print this map](#)

myTopo.com

GET A
CUSTOM
MAP PRINT

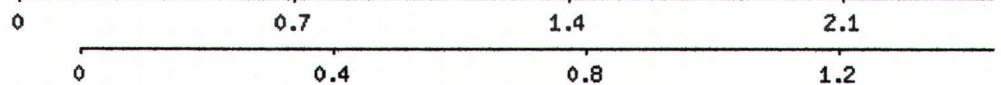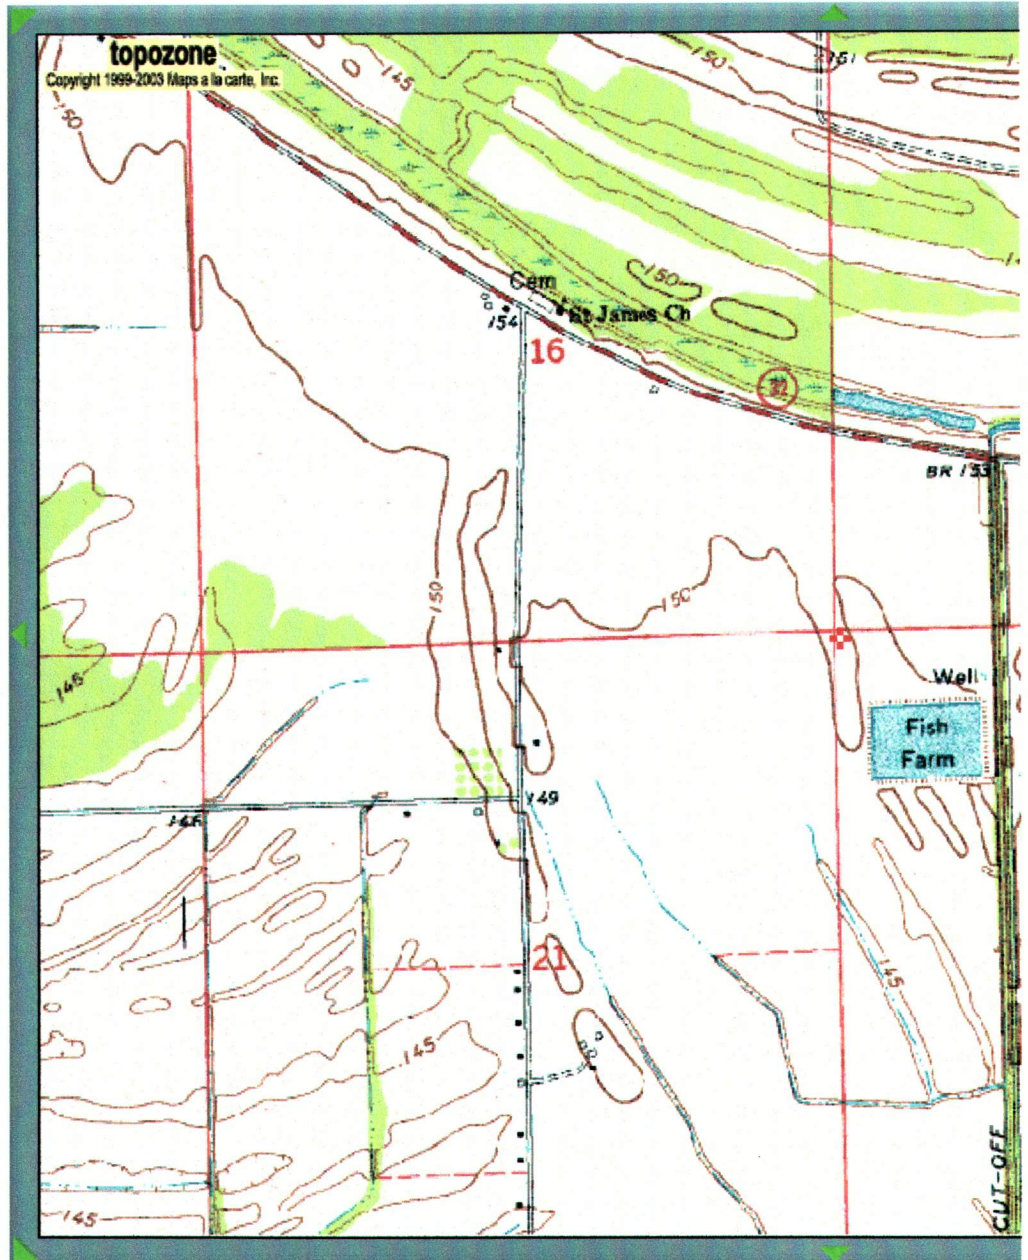

topozone

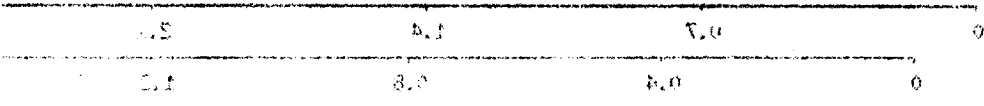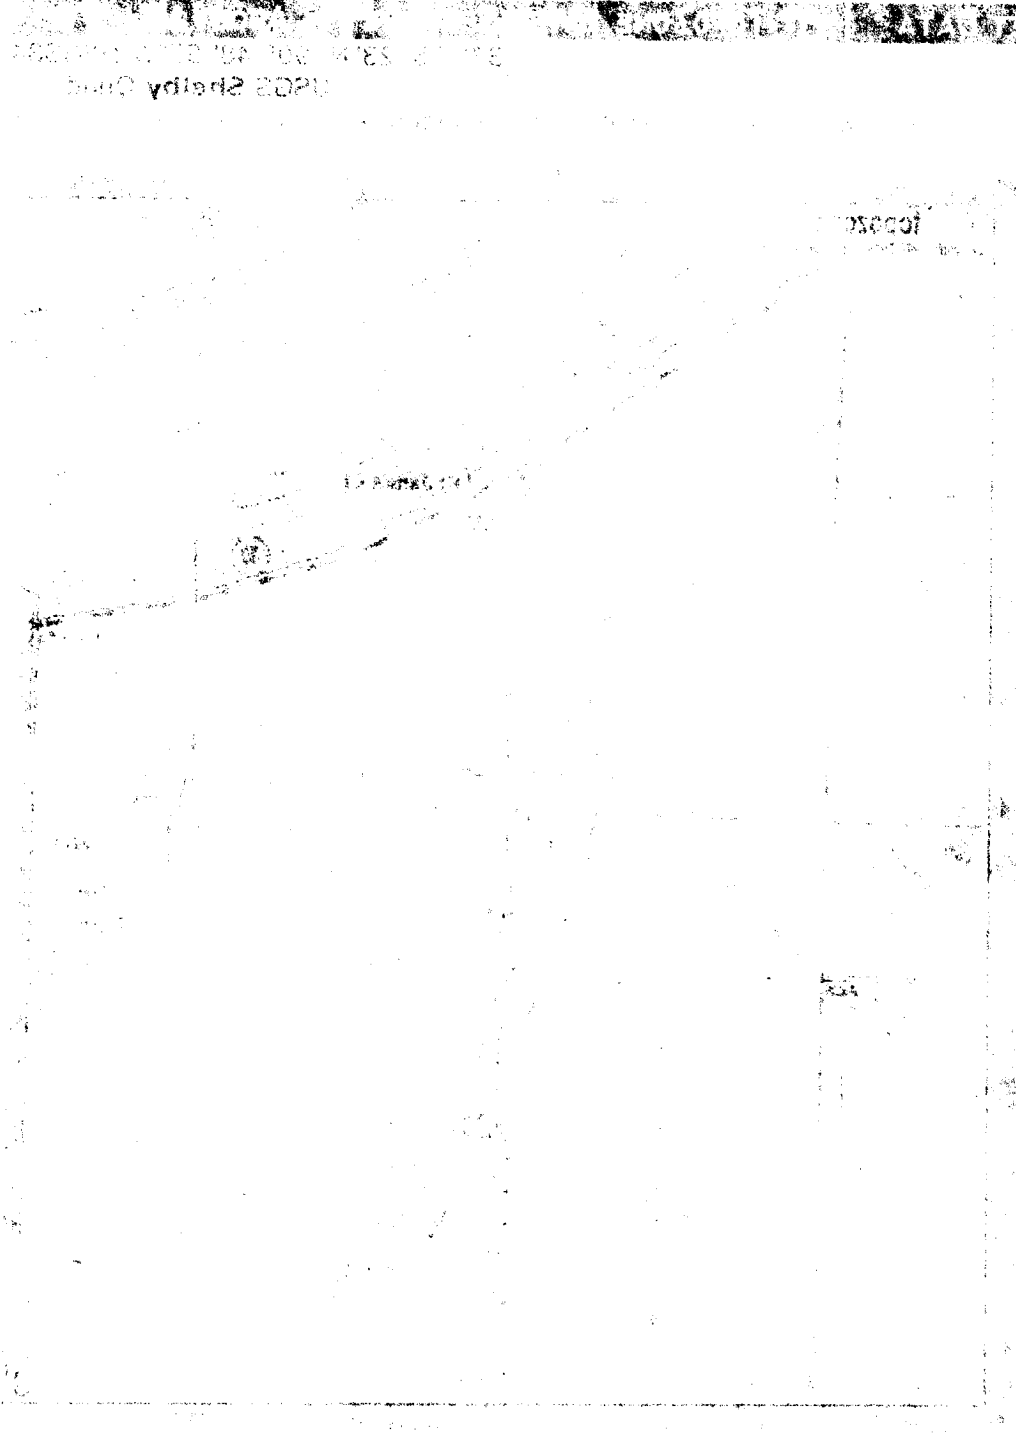

Map Options

- Topo Download
- Print to Desktop
- Update Topo Maps
- 1:250,000 Scale
- 1:500,000 Scale
- 1:1,000,000 Scale
- Map Style
- Small
- Medium
- Large
- View Scale
-
- Update Map
- Coordinate Format
- Coordinate System
-
- Show Target

