



If well telescopes, please sketch and show depths.

GROUND LEVEL


SECTION \_\_\_\_\_

Please indicate well location X.

Pump Capacity (GPM) <b>2500</b>	No. of Stages <b>1</b>	Setting Depth <b>70 FT.</b>
------------------------------------	---------------------------	--------------------------------

**PUMP TEST**

Well yielded NOT TESTED GPM with a drawdown of \_\_\_\_\_ ft. after \_\_\_\_\_ hours of pumping

**LOG DATA**

TYPE OF LOG RUN (Check One):  No Log Run  
 Electric,  Gamma Ray,  Density,  Sonic,  Neutron,  
 Other (Describe) \_\_\_\_\_

Name of Organization Running Log  
 N/A

**GEOLOGICAL DATA (Office Use Only)**

Surface Elev.	Geologic Unit	Unit Thickness	Depth to Top
Subs SWL	Date	Analysis	Aquifer Test

Driller's Remarks  
 Layne File No. 22-9246

---



---




---



---

If more than one screen, show location of each on sketch.

# topozone

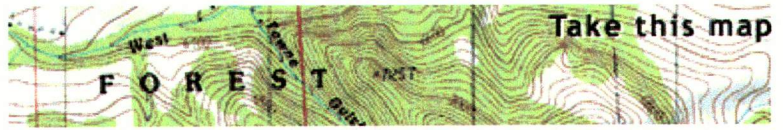

VIEW MAPS GET DATA MY TOPOZONE WEB SERVICES ABOUT US

33° 53' 58"N, 90° 47' 20"W (WGS84)  
USGS **Shelby** Quad

[View TopoZone Pro](#) aerial photos, shaded relief, street maps, interact

Map/Photo Info

Topo Download

Photo Download

### USGS Topo Maps

1:24K/25K Series

1:100K Series

1:250K Series

### Map Size

Small

Medium

Large

### View Scale

1 : 50,000

Update Map

### Coordinate Format

D/M/S

### Coordinate Datum

WGS84/NAD83

Show target



[Email this map](#)

[Bookmark this map](#)

[Print this map](#)

myTopo.com

GET A  
CUSTOM  
MAP PRINT

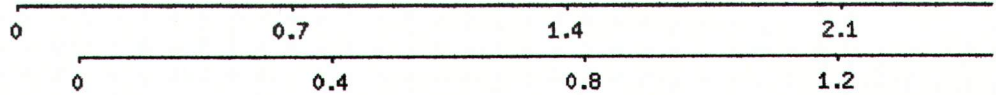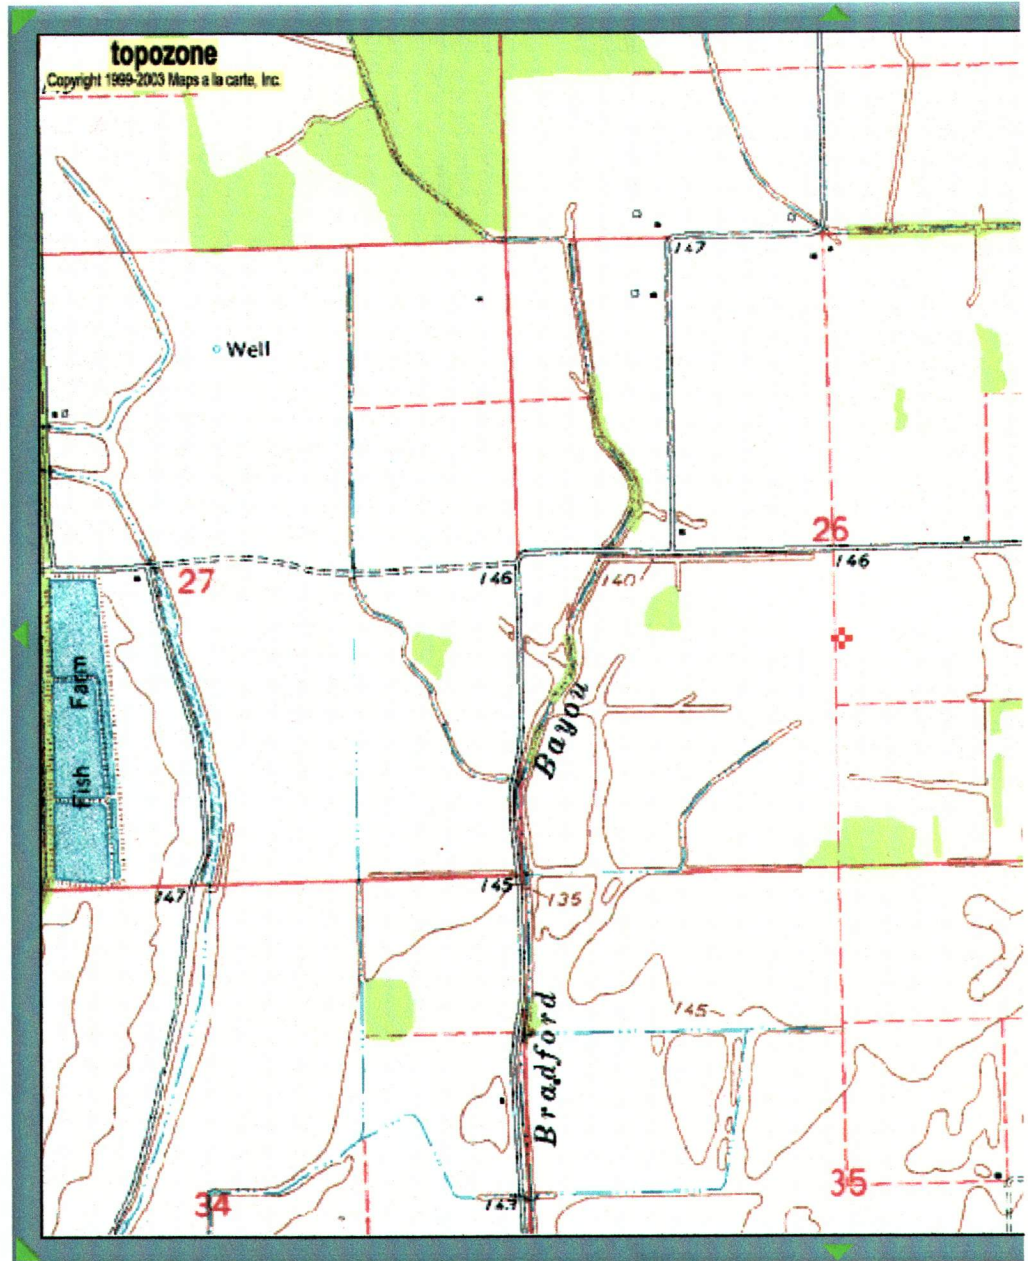

# topozone

Topographic Map of the United States

USA Shaded Relief

Topographic Map

View Scale: 1:50,000

Map Style: Shaded Relief

Map Data: USGS

Map Projection: UTM

Map Datum: NAD83

Map Units: Meters

Map Resolution: 30m

Map Scale: 1:50,000

Map Style: Shaded Relief

Map Data: USGS

Map Projection: UTM

Map Datum: NAD83

Map Units: Meters

Map Resolution: 30m

