County:	Boliva	r, 011	
Permit #:	GW 4	1009	$\prod M$
Irrig Daller	ation E	quipmen	t, line
Date drill	ing completed:	4-5-05	

State Well Report

Part 1

Office of Land and Water Resources
P.O. Box 10631
Jackson, MS 39289-0631
(601)961-5210
(601)354-6938 (fax)

For Office Use Only:
Aquifer:
Well #: D - 135
L. S. Elevation:
E-log #:

State Law requires that this report be prepared by the driller in detail and filed with the Department within 30 days of completion of drilling of the well.

30 days of completion of drilling of the well.	•
Well Owner Information	Well Location
Parks Place	Latitude: 33 • 56 • 40 N Longitude: 0 • 49 • 28 W
Owner Name c/o John Denton	Latitude: Longitude: Longitude:
Mailing Address: Box 189	Method of Lat/Long (circle one): Conventional Survey,
·	USGS quad, Hand-held GPS, Survey-grade GPS
Chalby MC 20774	
Shelby, MS 38774 City State Zin Code	SE 12NW 14 Sec 9 Twn 24N Rng 6W
	Distance Direction Nearest Town
Telephone No. (662-843-0525	4 Miles West of Shelby
Well	Data
Purpose of Well (circle one) Home Industrial Public Supply (Irrigation Fish Culture Other
Date well drilling started: $4-5-05$ Date	well drilling completed: $4-5-05$
If flowing, method of flow regulation: Valve Other (describe)
Static Water Level: 37 feet above or selow (circle one)	land surface Date measured: 4-5-05
Method of Measurement (circle one) steel tape electric tape	e air line other:
Hole depth: 126' Well depth: 126'	i de la companya de
	wen ground to a depth of
Type of grout (circle one): Cement entonite Mix	
Casing length: 86' feet Casing diameter: 16	•
Screen length: 40' feet Screen diameter: 16	inches Type of screen: PVC Sch. 40
Screen slot size: . 050 inches Setting depth: From	. 87 feet to 126 feet
Type of completion (circle all applicable): Gravel packed Under	areamed Telescoped Open hole Natural Development
Other (describe):	
Top of lap pipe or reduction in casing: feet. If	telescoped or more than one screen, describe on back of page
	- ·· ·
Logs run (circle all applicable): No log run Electric Gamma Ra	y Density Sonic Neutron Other:
Name of organization running log(s):	·
I certify that the well was drilled, constructed, and completed in	accordance with all applicable requirements of the Mississippi
Department of Environmental Quality and/or the Mississippi De	partment of Health regulations and state laws.
Irrigation Equipment Inc. Patrick M. Chism 0695	Patrick M Chim
Print Name of Water Well Contractor and License No.	Signature of Water Well Contractor

BY. ULWA


44 77 200

D-135

Ground Level	·
·	

Description of Formations Encountered	From	To
Clay	0	21
Fine Sand Fine Sand/gravel Med. Sand/gravel	22	
Fine Sand/gravel	61	70
Med. Sand/gravel	71	126
· · · · · · · · · · · · · · · · · · ·		
•		
	_	

If more than one screen, show location of each on sketch

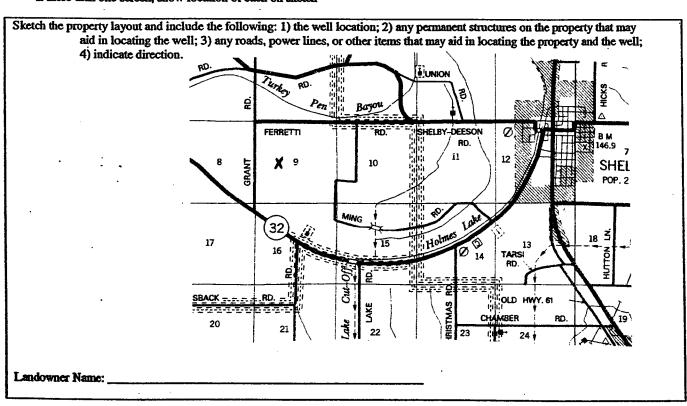

STATE WELL REPORT

Part 2

Bolivar County: Permit#: GW4009 Irrigation Equipment 4-5-05 Date completed:

Pump Installer's Completion Report
Mississippi Department of Environmental Quality
Office of Land and Water Resources P.O. Box 10631 Jackson, MS 39289-0631 (601)961-5210 (601)354-6938 (fax)

For Office Use Only:	
Aquifer:	
Well #: D - 135	_
Elevation:	_

Well Owner Information Parks Place	Well Location
Owner Name: c/o John Denton	Latitude: Longitude:
Mailing Address: Box 189	Method of Lat/Long (circle one): Conventional Survey,
	USGS quad, Hand-held GPS, Survey-grade GPS
Shelby, MS 38774 City State Zip Code	SE 1/4 NW 1/4 Sec 9 Twn 24N Rng 6W
•	Distance Direction Nearest Town
662-843-0525 Telephone No. ()	4 Miles West of Shelby
Pump Type Circle one	Power Type Circle one
Air Lift Jet Submersible	Diesel Engine Gasoline Engine Natural Gas
Bucket Piston Turbine	Electric Motor Hand Tractor PTO
Centrifugal Rotary Flowing Well	Windmill Other (specify):
Other (specify):	Horse Power Rating of Motor: 60
Date Pump Installed: $4-5-05$	Setting Depth: 70 feet
Rated Pump Capacity: 2500-3000 Gallons Per Minute	Number of Stages:1
Pump Test Data	Method of Measuring Water Level Circle one
Date Well Tested:	Air Line Electric Measuring Line Steel Tape
Static Water Level (A):Feet Below Land Surface	Other (specify):
Pumping Water Level (B):Feet Below Land Surface	Outer (specify).
Drawdown [(B) – (A)]:Feet Below Land Surface	For flowing well, measured shut in head:feet
	Well yieldedGPM with a drawdown of
Test Pumping Rate:Gallons Per Minute	
	feet afterhours of pumping

Signature of Pump Installer Print Name of Pump Installer and License No. (if applicable)

APR 27 2005