

# State Well Report

## Part I

Mississippi Department of Environmental Quality  
Office of Land and Water Resources  
P.O. Box 10631  
Jackson, MS 39289-0631  
(601)961-5210  
(601)354-6938 (fax)

For Office Use Only:

Aquifer: \_\_\_\_\_  
Well #: D-136  
L. S. Elevation: \_\_\_\_\_  
E-log #: \_\_\_\_\_

County: Bolivar 011  
Permit #: GW 40092  
Irrigation Equipment, Inc.  
Driller: \_\_\_\_\_  
Date drilling completed: 4-4-05

State Law requires that this report be prepared by the driller in detail and filed with the Department within 30 days of completion of drilling of the well.

Well Owner Information	Well Location
Owner Name: <u>Parks Place</u> <u>c/o John Denton</u>	Latitude: <u>33. 58. 01N</u> Longitude: <u>90. 48. 41W</u>
Mailing Address: <u>Box 189</u>	Method of Lat/Long (circle one): <u>Conventional Survey</u>
<u>Shelby, MS 38774</u>	USGS quad, <u>Hand-held GPS</u> , Survey-grade GPS <input checked="" type="checkbox"/>
City State Zip Code	<u>12 1/4 SW 1/4 Sec 3 / Twn 24N Rng 6W</u>
Telephone No. ( <u>662</u> ) <u>843-0525</u>	Distance Direction Nearest Town <u>4 Miles West of Shelby</u>

**Well Data**

Purpose of Well (circle one) Home Industrial Public Supply Irrigation Fish Culture Other: \_\_\_\_\_

Date well drilling started: 4-4-05 Date well drilling completed: 4-4-05

If flowing, method of flow regulation: Valve \_\_\_\_\_ Other (describe) \_\_\_\_\_

Static Water Level: 37' feet above or below (circle one) land surface Date measured: 4-5-05

Method of Measurement (circle one) steel tape electric tape air line other: \_\_\_\_\_

Hole depth: 125' Well depth: 125' Well grouted to a depth of 10 feet

Type of grout (circle one): Cement Bentonite Mix

Casing length: 85 feet Casing diameter: 16 inches Type of casing: PVC Sch. 40

Screen length: 40 feet Screen diameter: 16 inches Type of screen: PVC Sch. 40

Screen slot size: .050 inches Setting depth: From 86 feet to 125 feet

Type of completion (circle all applicable): Gravel packed Underreamed Telescoped Open hole Natural Development  
Other (describe): \_\_\_\_\_

Top of lap pipe or reduction in casing: \_\_\_\_\_ feet. If telescoped or more than one screen, describe on back of page

Logs run (circle all applicable): No log run Electric Gamma Ray Density Sonic Neutron Other: \_\_\_\_\_

Name of organization running log(s): \_\_\_\_\_

I certify that the well was drilled, constructed, and completed in accordance with all applicable requirements of the Mississippi Department of Environmental Quality and/or the Mississippi Department of Health regulations and state laws.

Irrigation Equipment INC.  
Patrick M. Chism 0695

Patrick M Chism

Print Name of Water Well Contractor and License No.

Signature of Water Well Contractor

RECEIVED  
APR 21 2005  
BY OLWF

If well telescopes please sketch below and show depths.

D-136

Ground Level

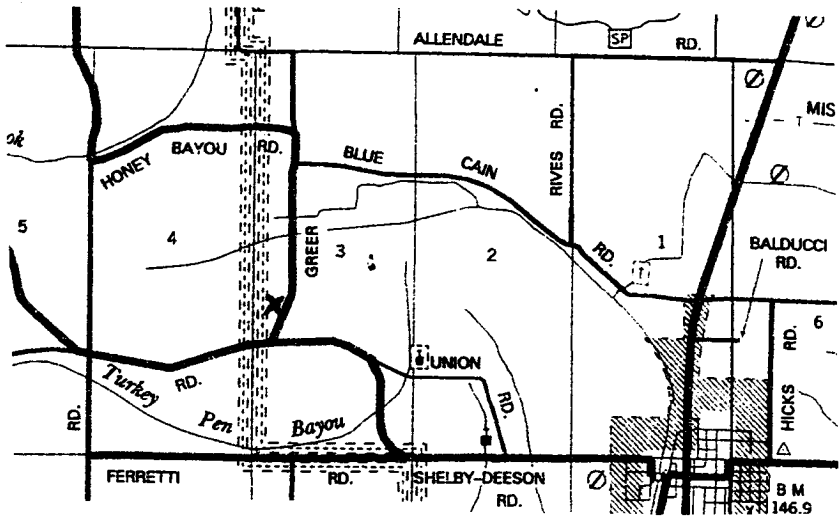

Description of Formations Encountered

From To

Clay	0	34
Fine Sand	35	45
Fine Sand/gravel	46	74
Med. Sand/gravel	75	125

If more than one screen, show location of each on sketch

Sketch the property layout and include the following: 1) the well location; 2) any permanent structures on the property that may aid in locating the well; 3) any roads, power lines, or other items that may aid in locating the property and the well; 4) indicate direction.



Landowner Name: \_\_\_\_\_

*Patrick M. Chin*  
Signature of Water Well Contractor

# STATE WELL REPORT

## Part 2

**Pump Installer's Completion Report**  
 Mississippi Department of Environmental Quality  
 Office of Land and Water Resources  
 P.O. Box 10631  
 Jackson, MS 39289-0631  
 (601)961-5210  
 (601)354-6938 (fax)

County: Bolivar  
 Permit #: BW40092  
 Irrigation Equipment  
 Driller: \_\_\_\_\_  
 Date completed: 4-5-05

For Office Use Only:

Aquifer: \_\_\_\_\_  
 Well #: D-136  
 Elevation: \_\_\_\_\_

**This report should be prepared by the pump installer in detail and filed with the Department within 30 days of the installation of pump.**

Well Owner Information	Well Location
Owner Name: <u>Parks Place</u> <u>c/o John Denton</u>	Latitude: _____ Longitude: _____
Mailing Address: _____ <u>Box 189</u>	Method of Lat/Long (circle one): <u>Conventional Survey</u> , <u>USGS quad</u> , <u>Hand-held GPS</u> , <u>Survey-grade GPS</u>
<u>Shelby, MS 38774</u> <small>City State Zip Code</small>	<u>1/4</u> <u>1/4</u> Sec <u>3</u> Twn <u>24N</u> Rng <u>6W</u>
Telephone No. ( <u>662-843-0525</u> )	Distance Direction Nearest Town <u>4</u> Miles <u>West</u> of <u>Shelby</u>

Pump Type Circle one	Power Type Circle one
Air Lift      Jet <u>Submersible</u>	<u>Diesel Engine</u> Gasoline Engine      Natural Gas
Bucket      Piston <u>Turbine</u>	Electric Motor      Hand      Tractor PTO
Centrifugal      Rotary      Flowing Well	Windmill      Other (specify): _____
Other (specify): _____	Horse Power Rating of Motor: <u>60</u>
Date Pump Installed: <u>4-5-05</u>	Setting Depth: <u>70</u> feet
Rated Pump Capacity: <u>2500-3000</u> Gallons Per Minute	Number of Stages: <u>1</u>

Pump Test Data	Method of Measuring Water Level Circle one
Date Well Tested: _____	Air Line      Electric Measuring Line      Steel Tape
Static Water Level (A): _____ Feet Below Land Surface	Other (specify): _____
Pumping Water Level (B): _____ Feet Below Land Surface	For flowing well, measured shut in head: _____ feet
Drawdown [(B) - (A)]: _____ Feet Below Land Surface	Well yielded _____ GPM with a drawdown of _____ feet after _____ hours of pumping
Test Pumping Rate: _____ Gallons Per Minute	
Duration of Pump Test (minimum 4 hours): _____ hours	

I HEREBY CERTIFY that the above statements are true to the best of my knowledge.

Patrick M. Chism 0695      Patrick M Chism  
 Print Name of Pump Installer and License No. (if applicable)      Signature of Pump Installer

RECEIVED  
 APR 27 2005  
 BY: OLWF