		Deport [For Office Use Only:
-	State Wel	I Repos	
	Par	t I	Aquifer
Bolivar	Par Mississippi Department C Office of Land and	Water Resources	Aquifer:
emit#: <u>Gw4057</u> rrigation Equipment	Office of Land and P.O. Bo	x 10631	L. S. Elevation:
camit#: GU Equipment	Tackson MS	39289-0031	L. S. Enviant
Driller:	Jackson, 19	61-3410	E-log #:
5-3-05	(601)354	_6938 (fax)	L within
rrigation Equipment Driller: Date drilling completed:5-3-05		tailler in detail and filed	with the Department "
Date drilling completed:	eport be prepared by the		n I contion
State Law requires that this is 30 days of completion of drilli	ng of the well.	W	си Licenson 00,50,6 "
Well Owner and		33.57 ,4	1." ⁹ Longitude: <u>90.50, 6</u> "
Owner NameA & B Farm	S		.). Conventional Survey,
Owner Name		Method of Lat/Long (circle	e one): Conventional Survey,
Mailing Address: Box 575		trace and Hand-h	eld GPS, Survey-grade GPS
		USUS quau, many	24NK 6W
		1R 1/2 Sec_5	Twn 24N Rng 6W
Rosedale	MS 38769		
City		Distance Direction	ofShelby
662 759-35	11	<u>5</u> <u>Miles West</u>	
Telephone No. ()			
	Wel	Data	
		Eich Cultur	e Other:
Purpose of Well (circle one) Home	Industrial Public Supply		
Date well drilling started:5	-3-05 Date	well drilling completed:	5-3-05
If flowing, method of flow regulation	: Valve Other	(describe)	
Static Water Level: 34' f	eet shove or felow icircle one) land surface Date measu	red: 5-4-0 <u>5</u>
Method of Measurement (circle one)			
	steel tape electric tap	pe air line other: _	
Method of Measurement (circle one) Hole depth: We	steel tape electric tap ell depth: <u>117</u>	pe air line other: _	
	steel tape electric tap ell depth: <u>117</u>	pe air line other:	
Hole depth: We Type of grout (circle one): Cemen	steel tape electric tap ell depth: <u>117</u>	pe air line other: Well grouted to a depth x	of <u>10</u> feet
Hole depth: <u>117'</u> We Type of grout (circle one): Cemen Casing length: <u>77</u> feet	steel tape electric tag ell depth: <u>117'</u> nt Bentonite Mi Casing diameter: <u>10</u>	pe air line other: Well grouted to a depth x inches Type of casin	of <u>10</u> feet g: PVC 160
Hole depth: <u>117'</u> We Type of grout (circle one): Cemen Casing length: <u>77</u> feet Screen length: <u>40</u> feet	steel tape electric tag ell depth: <u>117'</u> nt Bentonite Mi Casing diameter: <u>10</u>	pe air line other: Well grouted to a depth x inches Type of casin inches Type of scree	of <u>10</u> feet g: <u>PVC 160</u> n: <u>PVC 160</u>
Hole depth: <u>117'</u> We Type of grout (circle one): Cemen Casing length: <u>77</u> feet Screen length: <u>40</u> feet	steel tape electric tag ell depth: <u>117'</u> nt Bentonite Mi Casing diameter: <u>10</u>	pe air line other: Well grouted to a depth x inches Type of casin inches Type of scree	of <u>10</u> feet g: <u>PVC 160</u> n: <u>PVC 160</u>
Hole depth: 117' We Type of grout (circle one): Cemen Casing length: 77 feet Screen length: 40 feet Screen slot size: .050 inc	steel tape electric tap ell depth: <u>117'</u> tt Bentonite Mi Casing diameter: <u>10</u> Screen diameter: <u>10</u> shes Setting depth: From	pe air line other: Well grouted to a depth x inches Type of casin inches Type of scree 78feet to	of <u>10</u> feet g: <u>PVC 160</u> n: <u>PVC 160</u> 117' <u>feet</u>
Hole depth: We Type of grout (circle one): Cemen Casing length: feet Screen length: feet	steel tape electric tap ell depth: <u>117'</u> tt Bentonite Mi Casing diameter: <u>10</u> Screen diameter: <u>10</u> shes Setting depth: From	pe air line other: Well grouted to a depth x inches Type of casin inches Type of scree 78feet to	of <u>10</u> feet g: <u>PVC 160</u> n: <u>PVC 160</u> 117' feet
Hole depth: 117' We Type of grout (circle one): Cemen Casing length: 77 feet Screen length: 40 feet Screen slot size: .050 inc	steel tape electric tap ell depth: <u>117'</u> tt Bentonite Mi Casing diameter: <u>10</u> Screen diameter: <u>10</u> shes Setting depth: From	pe air line other: Well grouted to a depth x inches Type of casin inches Type of scree 78feet to	of <u>10</u> feet g: <u>PVC 160</u> n: <u>PVC 160</u> 117' <u>feet</u>
Hole depth: <u>117'</u> Wo Type of grout (circle one): Cemen Casing length: <u>77</u> feet Screen length: <u>40</u> feet Screen slot size: <u>•050</u> inc Type of completion (circle all applica	steel tape electric tag ell depth: <u>117'</u> nt Bentonire Mi Casing diameter: <u>10</u> Screen diameter: <u>10</u> screen diameter: <u>10</u> thes Setting depth: From able): Gravel packed Und Other (describe): <u></u>	pe air line other: Well grouted to a depth x inches Type of casin inches Type of scree 78feet to lerreamed Telescoped (of <u>10</u> feet g: <u>PVC 160</u> n: <u>PVC 160</u> 117' feet Dpen hole Natural Development
Hole depth: <u>117'</u> We Type of grout (circle one): Cemen Casing length: <u>77</u> feet Screen length: <u>40</u> feet Screen slot size: <u>050</u> inc Type of completion (circle all applica Top of lap pipe or reduction in casing	steel tape electric tap ell depth: <u>117'</u> nt <u>Bentonite</u> Mi Casing diameter: <u>10</u> Screen diameter: <u>10</u> screen diameter: <u>10</u> whes Setting depth: From able): <u>travel packed</u> Und Other (describe):feet. If	pe air line other:	of <u>10</u> feet g: <u>PVC 160</u> n: <u>PVC 160</u> 117'feet Open hole Natural Development e screen, describe on back of page
Hole depth: <u>117'</u> We Type of grout (circle one): Cemen Casing length: <u>77</u> feet Screen length: <u>40</u> feet Screen slot size: <u>050</u> inc Type of completion (circle all applica Top of lap pipe or reduction in casing	steel tape electric tap ell depth: <u>117'</u> nt <u>Bentonite</u> Mi Casing diameter: <u>10</u> Screen diameter: <u>10</u> screen diameter: <u>10</u> whes Setting depth: From able): <u>travel packed</u> Und Other (describe):feet. If	pe air line other:	of <u>10</u> feet g: <u>PVC 160</u> n: <u>PVC 160</u> 117'feet Dpen hole Natural Development e screen, describe on back of page
Hole depth: <u>117'</u> We Type of grout (circle one): Cemen Casing length: <u>77</u> feet Screen length: <u>40</u> feet Screen slot size: <u>050</u> inc Type of completion (circle all applicat Top of lap pipe or reduction in casing Logs run (circle all applicable): to let	steel tape electric tap ell depth: <u>117'</u> nt <u>Bentonite</u> Mi Casing diameter: <u>10</u> Screen diameter: <u>10</u> screen diameter: <u>10</u> screen diameter: <u>10</u> thes Setting depth: From able): <u>Gravel packed</u> Und Other (describe): <u>feet. If</u> og run Electric Gamma Ra	pe air line other:	of <u>10</u> feet g: <u>PVC 160</u> n: <u>PVC 160</u> <u>117'</u> feet Open hole Natural Development e screen, describe on back of page
Hole depth: <u>117'</u> We Type of grout (circle one): Cemen Casing length: <u>77</u> feet Screen length: <u>40</u> feet Screen slot size: <u>050</u> inc Type of completion (circle all applica Top of lap pipe or reduction in casing Logs run (circle all applicable): to le	steel tape electric tag ell depth: <u>117'</u> nt Bentonite Mi Casing diameter: <u>10</u> Screen diameter: <u>10</u> screen diameter: <u>10</u> thes Setting depth: From able): travel packed Und Other (describe): <u>feet. If</u> og run Electric Gamma Ra	pe air line other:	of <u>10</u> feet g: <u>PVC 160</u> n: <u>PVC 160</u> <u>117'</u> feet Open hole Natural Development e screen, describe on back of page on Other:
Hole depth: 117' We Type of grout (circle one): Cemen Casing length: 77 feet Screen length: 40 feet Screen slot size: .050 inc Type of completion (circle all application in casing Logs run (circle all applicable): to lot Name of organization running log(s): I certify that the well was drilled, com	steel tape electric tap ell depth: <u>117'</u> at <u>Bentonite</u> Mi Casing diameter: <u>10</u> Screen diameter: <u>10</u> Screen diameter: <u>10</u> shes Setting depth: From able): (ravel packed) Und Other (describe): <u>feet. If</u> og run Electric Gamma Ra	pe air line other:	of <u>10</u> feet g: <u>PVC 160</u> n: <u>PVC 160</u> <u>117'</u> feet Open hole Natural Development e screen, describe on back of page on Other:
Hole depth: 117' We Type of grout (circle one): Cemen Casing length: 77 feet Screen length: 40 feet Screen slot size: .050 inc Type of completion (circle all application in casing Logs run (circle all applicable): No let Name of organization running log(s): I certify that the well was drilled, co Department of Environmental Qual	steel tape electric tap ell depth: <u>117'</u> at <u>Bentonite</u> Mi Casing diameter: <u>10</u> Screen diameter: <u>10</u> Screen diameter: <u>10</u> thes Setting depth: From able): <u>(ravel packed)</u> Und Other (describe): <u>feet. If</u> feet. If the org.run Electric Gamma Ra	pe air line other:	of <u>10</u> feet g: <u>PVC 160</u> n: <u>PVC 160</u> <u>117'</u> feet Open hole Natural Development e screen, describe on back of page on Other:
Hole depth: 117' We Type of grout (circle one): Cemen Casing length: 77 feet Screen length: 40 feet Screen slot size: .050 inc Type of completion (circle all application in casing Logs run (circle all applicable): No let Name of organization running log(s): I certify that the well was drilled, co Department of Environmental Qual Irrigation Equiption Equiption	steel tape electric tap ell depth: <u>117'</u> at <u>Bentonite</u> Mi Casing diameter: <u>10</u> Screen di screen diameter: <u>10</u> screen diameter: <u>10</u> screen diameter: <u></u>	pe air line other:	of <u>10</u> feet g: <u>PVC 160</u> n: <u>PVC 160</u> <u>117'</u> feet Open hole Natural Development e screen, describe on back of page on Other:
Hole depth: 117' We Type of grout (circle one): Cement Casing length: 77 feet Screen length: 40 feet Screen slot size: .050 inc Type of completion (circle all application in casing Logs run (circle all applicable): No let Name of organization running log(s): I certify that the well was drilled, co Department of Environmental Qual Irrigation Equipmet Patrick M. Chism	steel tape electric tap ell depth: <u>117'</u> the Bentonite Min Casing diameter: <u>10</u> Screen diameter: <u>10</u> scree	pe air line other:	of <u>10</u> feet g: <u>PVC 160</u> n: <u>PVC 160</u> <u>117'</u> feet Open hole Natural Development e screen, describe on back of page on Other:
Hole depth: 117' We Type of grout (circle one): Cemen Casing length: 77 feet Screen length: 40 feet Screen slot size: .050 inc Type of completion (circle all application in casing Logs run (circle all applicable): No let Name of organization running log(s): I certify that the well was drilled, co Department of Environmental Qual Irrigation Equiption Equiption	steel tape electric tap ell depth: <u>117'</u> the Bentonite Min Casing diameter: <u>10</u> Screen diameter: <u>10</u> scree	pe air line other:	of <u>10</u> feet g: <u>PVC 160</u> n: <u>PVC 160</u> <u>117'</u> feet Open hole Natural Development e screen, describe on back of page on Other:

RECEIVED

MAY 2 3 2005 BY: OLWR If well telescopes please sketch below and show depths.


Ground Level

D-137		-
Description of Formations Encountered	From	То
Clay Fine Sand Med. Sand	0	25
Med. Sand	2.6	55
Coarse Sand/gravel	56	75
Sand/gravel	76	117
		—]
	+	
	11	
	1	

•7

•

If more than one screen, show location of each on sketch

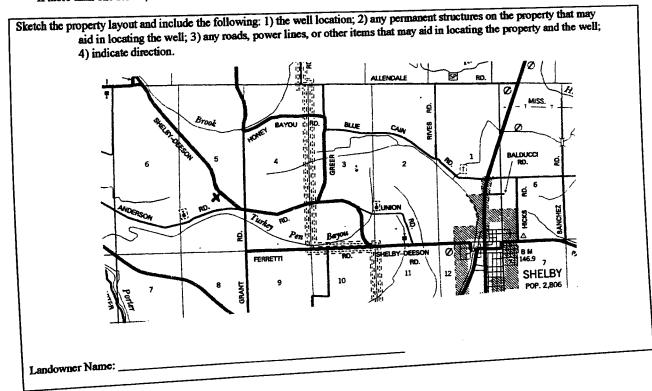

m Chisi

Signature of Water Well Contractor

Polivar	STATE WELJ Part	2 For Office Use Only:
County: Bolivar Permit#: <u>GW40571</u> Irrigation Equipment	Pump Installer's Cor Mississippi Department of J Office of Land and V P.O. Box J	Environmental Quality Aquifer: Water Resources
Driller:	Jackson, MS 39 (601)961- (601)354-69	9289-0631 Well #:
		ad filed with the Department within 30 days of the
Well Owner Informati	on	Well Location

₩ ₩¥

· · · · · · · · · · · · · · · · · · ·		
Owner Name: 2	A & B Farms	Latitude:Longitude:
Mailing Address: H	Box 575	Method of Lat/Long (circle one): Conventional Survey,
		USGS quad, Hand-held GPS, Survey-grade GPS
F	Rosedale, MS 38769	$\underline{ \frac{1}{4} \underline{ \frac{1}{4} \operatorname{Sec} 5}_{\text{Twn}} 24N_{\text{Rng}} 6W}$
Cit	ty State Zip Code	Distance Direction Nearest Town
6 6 Telephone No. (62-759-3511 _)	5_Miles_West_of_Shelby

Pum p Type Circle one		Power Type Circle one			
Air Lift	Jet	Submersible	Diesel Engine	Gasoline Engine	Natural Gas
Bucket	Piston	Turbine	Electric Motor)	Hand	Tractor PTO
Centrifugal	Rotary	Flowing Well	Windmill	Other (specify):	
Other (specify):			Horse Power Ratin	g of Motor: <u>10</u>	
Date Pump Installed:	5-4	-05	Setting Depth:	70	feet
Rated Pump Capacity:	500	Gallons Per Minute	Number of Stages:	1	

Pump Test Data	Method of Measuring Water Level Circle one		
Date Well Tested:	Air Line Electric Measuring Line Steel Tape		
Static Water Level (A):Feet Below Land Surface	Other (specify):		
Pumping Water Level (B):Feet Below Land Surface			
Drawdown [(B) – (A)]:Feet Below Land Surface	For flowing well, measured shut in head:feet		
Test Pumping Rate:Gallons Per Minute	Well yielded GPM with a drawdown of		
Duration of Pump Test (minimum 4 hours):hours	feet afterhours of pumping		

I HEREBY CERTIFY that the above statements are true to the best of a	my knowledge.
Patrick M. Chism 0695	Signature of Pump Installer
Print Name of Pump Installer and License No. (if applicable)	Signature of Pump Installer

MAY 2 3 2005 BY: OLWR

RECEIVED