	State W	ell Report	For Office Use Only:
County: Bolivar	Part 1		•
Permit #: GW 41087	Mississippi Department of Environmental Quality		Aquifer:
Irrigation Equipment	Office of Land and Water Resources P.O. Box 10631		Well #: <u>D-143</u>
Driller:		IS 39289-0631	L. S. Elevation:
Date drilling completed: $5 - 24 - 06$	(601)961-5210 (601)354-6938 (fax)		E-log #:
] (001)33	4-0958 (lax)	L-log #.
State Law requires that this rep		driller in detail and filed w	ith the Department within
<u>30 days of completion of drilling</u> Well Owner Informa	g of the Well. ation	Wel	Location
Owner Name Parks Place		Latitude: 33.57,07,7Longitude 90 48 55.7	
Mailing Address: C/o John Denton		Method of Lat/Long (circle one): Conventional Survey,	
Box 189		USGS quad, Hand-held GPS, Survey-grade GPS	
		NE _{1/2} NE 1/2 Sec 9	Twn ^{24N} Rng ^{6W}
Shelby, MS			
City Sta	te Zip Code	Distance Direction 3 Miles West	of <u>Shelby</u>
Telephone No. ()			
· · · · · · · · · · · · · · · · · · ·	Well	Data	
Purpose of Well (circle one) Home Ind	natrial Dublic Sucche	Fich Culture	Other
Date well drilling started:5-24-	Date v	well drilling completed:	J-24-00
If flowing, method of flow regulation: Val	lve Other (d	lescribe)	
Static Water Level: <u>36'</u> feet at	ove of below (circle one)	and surface Date measured:	5-26-06
Method of Measurement (circle one)		air line other:	
Hole depth: 121 Well dep	\sim	Well grouted to a depth of	feet
Type of grout (circle one): Cement	Bentonite Mix		
Casing length: <u>81</u> feet Casin	ng diameter: <u>10</u>	inches Type of casing:P	VC 160
Screen length: 40 feet Scre	en diameter 10	inches Type of somen	PVC 160
Screen slot size: <u>059</u> nches	Setting depth: From _	82 feet to 12	feet
Type of completion (circle all applicable):	Gravel packed Under	reamed Telescoped Open	hole Natural Development
	Other (describe):		
Top offer sing			
Top of lap pipe or reduction in casing:		-	een, describe on back of page
Logs run (circle all applicable): No log ru	n) Electric Gamma Ray	Density Sonic Neutron	Other:
Name of organization running log(s):	·		
I certify that the well was drilled, constr	· •		
Department of Environmental Quality a		partment of Health regulation	s and state laws.
Irrigation Equipm		14	MAND.
Patrick M. Chism	0695	Tahut_	Man
Print Name of Water Well Contractor and	License No.	Signature of	Water Well Contractor

• 1

÷


NECEIVED UN 0.7 2006 BY: OLWF If well telescopes please sketch below and show depths.

Ground Level

Clay 0 28 Fine Sand 29 37 Fine Sand/gravel .38 54 Med. Sand/gravel .55 721	Description of Formations Encountered	From To
Fine Sand 29 37 Fine Sand/gravel .38 54 Med. Sand/gravel .55 721		0 28
Fine Sand/gravel .38 54 Med. Sand/gravel -55 121	Fine Sand	
Med. Sand/gravel -55121	Fine Sand/gravel	
	Med. Sand/gravel	-55121
Image: Sector		
Image: Section of the section of t		
Image: Sector		
Image: Sector		

2

If more than one screen, show location of each on sketch

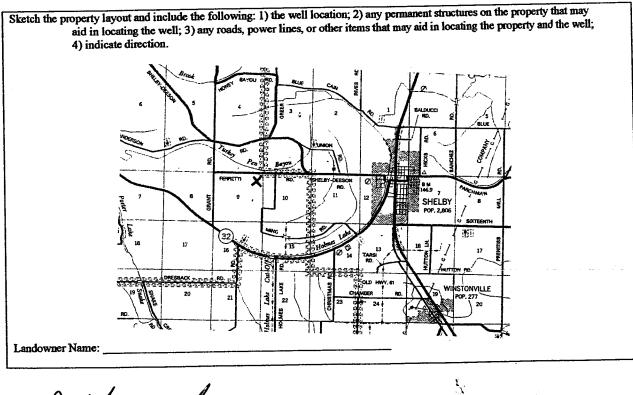

Signature of Water Well Contractor

	STATE W	ELL REPORT		
County: Bolivar		Part 2	For Office Use Only:	
Permit #: G(W) 41087	Mississippi Departme	Pump Installer's Completion Report Mississippi Department of Environmental Quality		
Irrigation Equipme	nt Office of Land	and Water Resources Box 10631	Well #:	
Date completed: $5-24-06$	Jackson,	MS 39289-0631		
Copy information from block on Part 1		1)961-5210 54-6938 (fax)		
This part of the report must be com report must be attached and both p	 pleted by a licensed water well	l contractor or a licensed pump is	ustaller. A copy of Part 1 of	
Vell Owner In	formation	Wel	Location	
Owner Name: Parks Pla	ce	Latitude:	Longitude:	
Mailing Address:c/o John Denton		Method of Lat/Long (check or	Method of Lat/Long (check one): Conventional Survey	
Box 189		USGS quad, Hand-held		
	MS 38774	<u>4 4 8 8 9</u>		
	State Zip Code			
-		Distance Direction	Nearest Town	
Telephone No. ()		<u> </u>	fShelby	
Pump T	урс		wer Type	
Circle o	ne	C	ircle one	
Air Lift Jet	Submersible	Diesel Engine Gasolin	e Engine Natural (
Bucket Piston	Turbine	Electric Motor) Hand	Tractor P	
Centrifugal Rotary	Flowing Well	Windmill Other	(specify):	
Other (specify):		Horse Power Rating of Motor	15	
	6-06	Setting Depth:70		
750		Number of Stages:1		
Rated Pump Capacity:	Gallons Per Minute			
Pump Test Data			easuring Water Level	
Date Well Tested:			asuring Line Steel Tap	
Static Water Level (A):Feet Below Land Surface			•	
Pumping Water Level (B):Feet Below Land Surface		Other (specify):		
Drawdown [(B) - (A)]:		For flowing well, measured s	hut in head:	
	ping Rate: Gallons Per Minute		GPM with a drawdown o	
Duration of Pump Test (minimum 4	hours):hours	feet after _	hours of pum	

JUN 07 2006 BY: OLWR