	State Well Report	
County: Balivar	Part 1 – Driller's Log	For
Pormit #: 6W 43126	Mississippi Department of Environmental Quality Office of Land and Water Resources	Aquifor:
Driller Clarence McMury	P.O. Box 2307 Jackson, MS 39225	Well#:
Date drilling completed: 44-09	(601)961- 5210 (601)961- 5228 (fax)	L S. Elevat

Office Use Only:

State Law requires that this report be prepared by the license holder responsible for the work and filed with the
Department at the above address within 30 days of completion of drilling of the well or borehole.
Information on Well Owner (I.andowner if borehole is not for a water well)
Owner Name KMC luc. Latitude: N33 " 54 "43.53" Largitude: W60° 47 "0.77" Method of Lat/Long (circle one): Conventional Survey,
Mailing Address: P. O. Bax 770 Method of Lat/Long (cirčle one): Conventional Survey, USOS quad. Hand-held GPS. Survey-grade GPS
Shelby MS 3877 Y City State Zip Code Distance Direction Nearest Town Miles of Wing Line Miles
Telephone No. (42) 719-0299
Well / Barchole Data
Date drilling started: 4-9-09 Date drilling completed. 4-9-09 Hole depth; 120' Hole diameter; 26"
Location of the source of any surface water used for drilling: hear by b: +ck Method of dosing and volume of Chlorine used in drilling and development:
Logs run (circle all applicable): No log run Mectric Gamma Ray Dens ty Sonic Neutron Other: Name of organization running log(s):
Purpose of borehole (check one): Water Well X Geolechnical/Geological Investigation Ground Source Heat Pump
Scismic Survey Other (describe) If drilling is not reluted to water well construction, skip the remainder of this block
If drilling is not reluted to water well construction, skip the remainder of this black
Purpose of Well (check one): Home Industrial Public Supply Irrigation Y Fish Culture Other:
If a flowing well, method of flow regulation: Valve Other (describe)
Static Water Level: 37.5 feet above or below circle one) land surface Date measured: 4-17-29
Method of Measurement (circle one) steel tape electric tape air line other:
Well depth: 120' Well grouted to a depth of 10 feet Type of grout (circle one): Men Cement Bentonite Mix
Casing length: 80 feet Casing diameter: 12 mones Type of casing: FUC
Screen length: 40 feet Screen diameter: 12 inches Type of screen: PVC
Screen slot size: , 050 inches Setting depth From FO feet to 120 feet
Type of completion (circle all applicable): <u>Gravel packed</u> Underreamed Telescoped Open hole Natural Development
Other (describe):
Top of lap pipe or reduction in ensing: A/A feet !!! telescoped or more than one screen, describe on next page

Form: OLWR-SWR-1A (04/08)

RECEIVED

APR 2.0 2009

BY: OLWF


The sketch below only required for water wells

If well telescopes, show depths on sketch Ground Level.

Description of formations encountered must be provi wells and boreholes, unless specifically exempted by regulations

Description	on of Formations Encountered	From (depth)	To (depth)
Clay	Fine Sand	Ground Level	15
Clar) Fine Sand	15	25_
Clay	1 Fine Sanch	25	32_
Clay, 9	ine 7 Coarse Soul, Grave	35	45
Cocks	Sand > pea grave.	45-	22
	e Sund 3 Grave 1	5 5	65
Coars	- Sand & Glave!	65	75-
	Sand > Gravel	75	85
Coars	e Sund Geravel	85-	62-
Coal	se Sund & Gravel	95	105
Cour	se sand blavel	105	115-
Coors	e Soul 96/avel	115-	120
		·-	
		m. mm	
L	· · · · · · · · · · · · · · · · · · ·		
		-	
	<u> </u>		ļ
<u> </u>			
 			
ļ			
ļ			
L			J

If more than one screen, show location of each on sketch

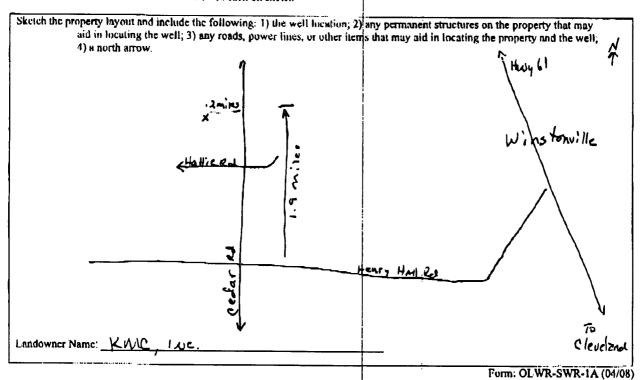

I certify that the well/borehole was drilled, constructed, and completed in accordance with all applicable requirements of the Mississippi Dopartment of Environmental Quality and the Mississippi Department of Health regulations, if applicable, and state

Claylor Miller 0-703 4-20-09
Print Name of Responsible Licensec and License No. Date

APR 2 0 2009

BY: OLWE

STATE	WELL	REPORT
-------	------	--------

County Bolivac Driller John Date completed __

Copy Information from block on Part 1

Part 2 Pump Installer's Completion Report
Mississippi Department of Environmental Quality
Office of Land and Water Resources
12.0. Box 2309
Jackson, MS 39225

(601)961-5210 (601)961-5228 (fox)

For Office Use Only:		
Aquifer:		
Woll#:	D-161	
Elevation		

report must be attached and both parts filed with the Department at t	ntractor or a licensed pump installer. A copy of Part 1 of the
Well Owner Information	Well Location
Owner Name: IC MC, INC	Latitude: <u>1835° 54'</u> 43.53" Longitude: <u>W90° 47' 0.77"</u>
'	Method of Lat/Long (check one): Conventional Survey
	USGS quad, Hand-held GPS, Survey-grade GPS
Shelby MS 38774 City Shu Zin Code	SE 1/5 E 1/4 Sec 23 2240 R. GA
11, 11, 11, 11, 11, 11, 11, 11, 11, 11,	Distance Direction Nearest Town
Telephone No. (662) 719 - 0259	Miles or Winstonville
Pump Type Circle one	Power Type Circle one
Air Lift Jet Submersible	Diese Engine Gasoline Engine Natural Gas
Bucket Piston Turbine	Electric Motor Hund Tractor PTO
Centrifugal Rotary Flowing Well	Windmill Other (specify):
Other (specify)	Horse Power Rating of Motor: 15hp
Date Pump Installed: 4-17-09	Setting Depth: , 80 feet
Rated Pump Cupucity: \$0.0 Gallons Per Minute	Number of Stages:
Pump Test Data	Method of Measuring Water Level
	Circle one
	Air Line Electric Measuring Line Steel Tape
Static Water Level (A): 32, 5 Foot Bolow Land Surface	Other (specify):
Pumping Water Level (B): Feet Below Land Surface	
Drawdown [(B) - (A)]: A Feet Below Land Surface	For flowing well, measured shut in head:
Test Pumping Rate: A) A Gallons Per Minute	Well yieldedGPM with a drawdown of
Duration of Pump Test (minimum 4 hours):N_	feet after hours of pumping

I HEREBY CERTIFY that the above statements are true to the best		
Classian Miller 0-703 Print Name of Pump Installer and License No. (if applicable)	Claston miller BECEIVE	
Print Name of Pump Installer and License No. (if applicable)	Office and the Common Transmillion	
	Form: OLWR-SWR-1B (04/08)	10
	APR 2 12 ZUU	13

BY: OLWE