

Never received
Part 2 3/13

Job # 10-192

County: Bolivar
 Permit #: GW-44270
 Driller: Pete Suppiger
 Date drilling completed: 4-28-10

State Well Report
Part 1 - Driller's Log
 Mississippi Department of Environmental Quality
 Office of Land and Water Resources
 P.O. Box 2309
 Jackson, MS 39225
 (601)961- 5210
 (601)961- 5228 (fax)

For Office Use Only:
 Aquifer: D168
 Well #: _____
 L. S. Elevation: _____
 E-log #: _____

State Law requires that this report be prepared by the license holder responsible for the work and filed with the Department at the above address within 30 days of completion of drilling of the well or borehole.

Information on Well Owner (Landowner if borehole is not for a water well)	Well or Borehole Location
Owner Name: <u>Bill ONeal K+G Farms</u>	Latitude: <u>33° 59' 12.5"</u> Longitude: <u>90° 47' 06.5"</u>
Mailing Address: <u>P.O. Box 26</u>	Method of Lat/Long (circle one): Conventional Survey,
<u>Shelby</u> <u>Ms.</u> <u>38774</u>	USGS quad <u>Hand-held GPS</u> , Survey-grade GPS <input checked="" type="checkbox"/>
City State Zip Code	<u>1R</u> <u>1/4</u> <u>NE</u> <u>1/4</u> Sec <u>2</u> <u>1</u> <u>Twn</u> <u>24N</u> <u>6W</u>
Telephone No. <u>662 398-5121</u>	Distance <u>2 1/2</u> Miles <u>NNW</u> of <u>Shelby, Ms.</u>

Well / Borehole Data

Date drilling started: 4-28 Date drilling completed: 4-28 Hole depth: 115' Hole diameter: 28"

Location of the source of any surface water used for drilling: Ditch 1/2 mi west of well

Method of dosing and volume of Chlorine used in drilling and development: Sodium Hypo Chlorite

Logs run (circle all applicable): No log run Electric Gamma Ray Density Sonic Neutron Other: _____

Name of organization running log(s): _____

Purpose of borehole (check one): Water Well Geotechnical/Geological Investigation _____ Ground Source Heat Pump _____

Seismic Survey _____ Other (describe) _____

If drilling is not related to water well construction, skip the remainder of this block

Purpose of Well (check one): Home _____ Industrial _____ Public Supply _____ Irrigation _____ Fish Culture Other: _____

If a flowing well, method of flow regulation: Valve _____ Other (describe) _____

Static Water Level: 40 feet above or below (circle one) land surface Date measured: 4-29

Method of Measurement (circle one) steel tape electric tape air line other: _____

Well depth: 115 Well grouted to a depth of 10 feet Type of grout (circle one): Neat Cement Bentonite Mix

Casing length: 75 feet Casing diameter: 16 inches Type of casing: PVC sch 40

Screen length: 40 feet Screen diameter: 16 inches Type of screen: PVC sch 40

Screen slot size: .032 inches Setting depth: From 75 feet to 115 feet

Type of completion (circle all applicable): Gravel packed Underreamed Telescoped Open hole Natural Development

Other (describe): _____

Top of lap pipe or reduction in casing: _____ feet. *If telescoped or more than one screen, describe on next page*

Form: OLWR-SWR-1A (04/08)

RECEIVED
 JUN 11 2010
 BY: OLWR

D168

The sketch below only required for water wells

Description of formations encountered must be provided for all wells and boreholes, unless specifically exempted by regulations

If well telescopes, show depths on sketch

Ground Level →

Description of Formations Encountered	From (depth)	To (depth)
	Ground Level	
Clay	0	25'
Clay & Fine Sand	25'	60'
Coarse Sand & Gravel	60'	115'

If more than one screen, show location of each on sketch

Sketch the property layout and include the following: 1) the well location; 2) any permanent structures on the property that may aid in locating the well; 3) any roads, power lines, or other items that may aid in locating the property and the well; 4) a north arrow.

See Attached Map

Landowner Name: Bill Oreal

Form: OLWR-SWR-1A (04/08)


I certify that the well/borehole was drilled, constructed, and completed in accordance with all applicable requirements of the Mississippi Department of Environmental Quality and the Mississippi Department of Health regulations, if applicable, and state laws.

Pete Sappington 0430
Print Name of Responsible Licensee and License No.

4-28-10
Date

Pete Sappington
Signature of Licensee

RECEIVED
JUN 21 2010
BY: OLWR

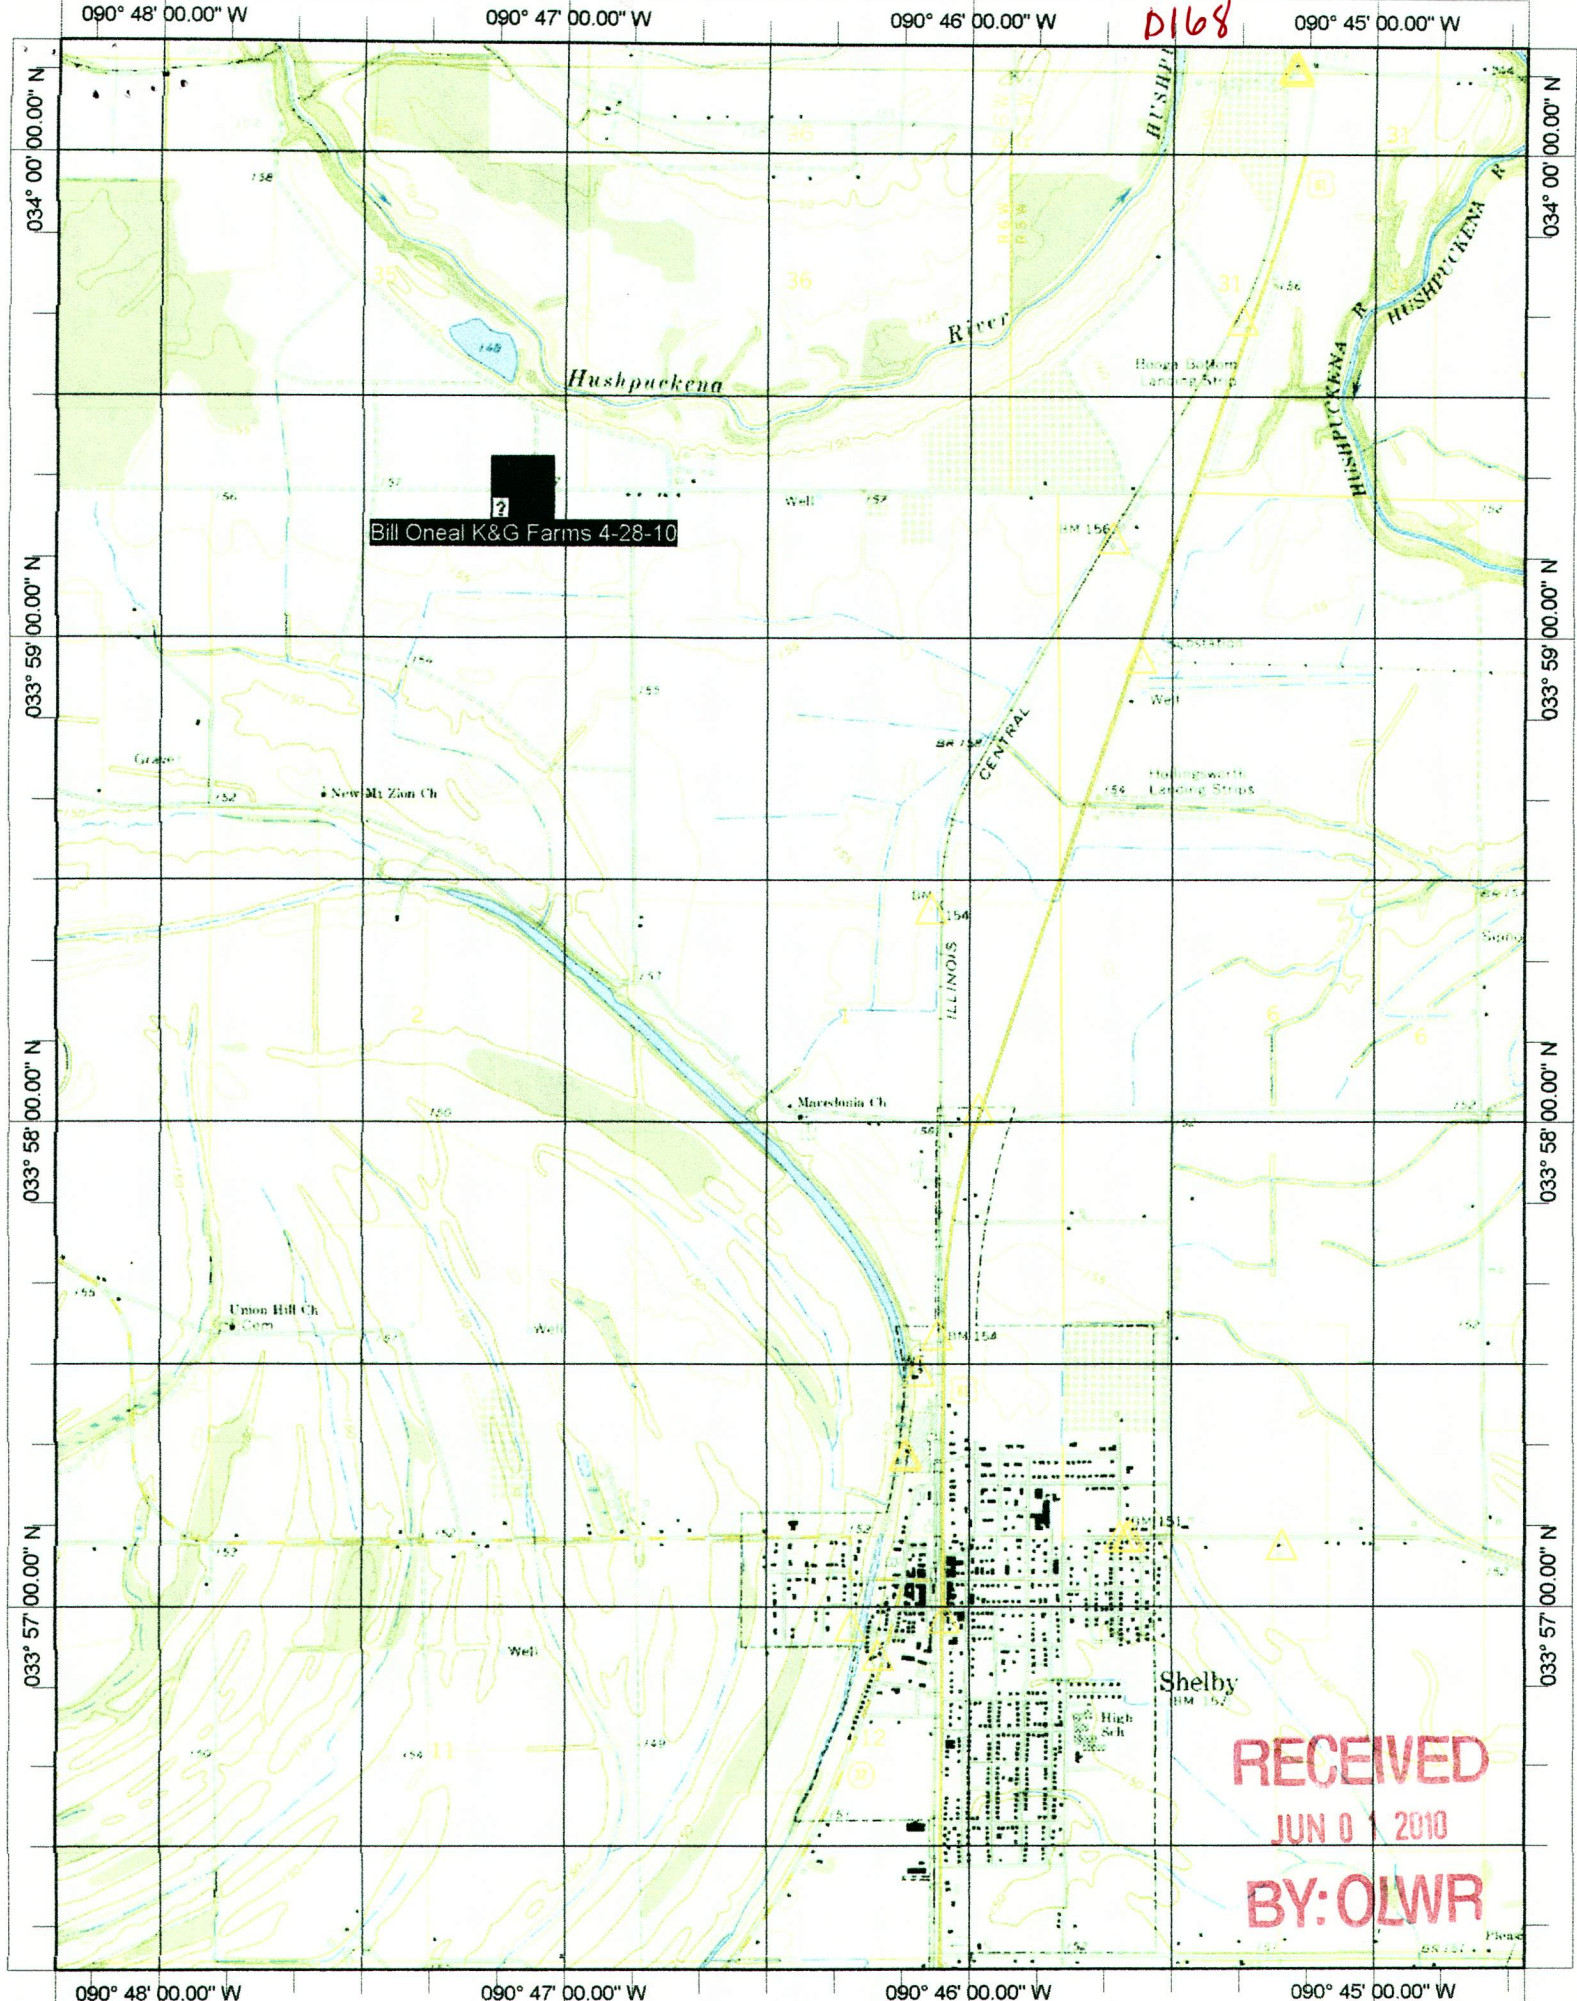

D168

Bill Oneal K&G Farms 4-28-10

RECEIVED
JUN 01 2010
BY: OLWR