
HE SP	e prop. Hy
State W County: BOLIVEN Permit # GW 438 0 Driller: J. NENCOME 0-773 Date drilling completed: $(b-9-10)$ State Law requires that this report be prepared by the 30 days of completion of drilling of the well. Well Owner Information Owner Name HE + SF Propert SLP Mailing Address: $P > 200000000000000000000000000000000000$	Vell Report Part 1 at of Environmental Quality Aquifer: Aquifer: D183 Well #: D183 US 39289-0631 U961-5210 E-log #:
City State Zip Code	NW SE Distance Direction Nearest Town O MilesO fSHELBY
	Data
If flowing, method of flow regulation: Valve Other (Static Water Level:feet above or below (circle one) Method of Measurement (circle one) steel tape electric tap Hole depth: (LO Well depth: (O S Type of grout (circle one): Cement Bentonite Min Casing length: feet Casing diameter: (G Screen length: feet Screen diameter: (G Screen slot size: inches Setting depth: From	b) land surface Date measured: pe air line other: Well grouted to a depth offeet ix inches Type of casing: inches Type of screen:
Type of completion (circle all applicable): Gravel packed Und	derreamed Telescoped Open hole Natural Development
Logs run (circle all applicable): No log run Electric Gamma R	in accordance with all applicable requirements of the Mississippi
JOHN NEWCOME 0.773	fol Nour
Print Name of Water Well Contractor and License No.	ignature of Water Well Contractor
	AUG 0 2 201
	SY: OLM

D183

If well telescopes please sketch below and show depths.

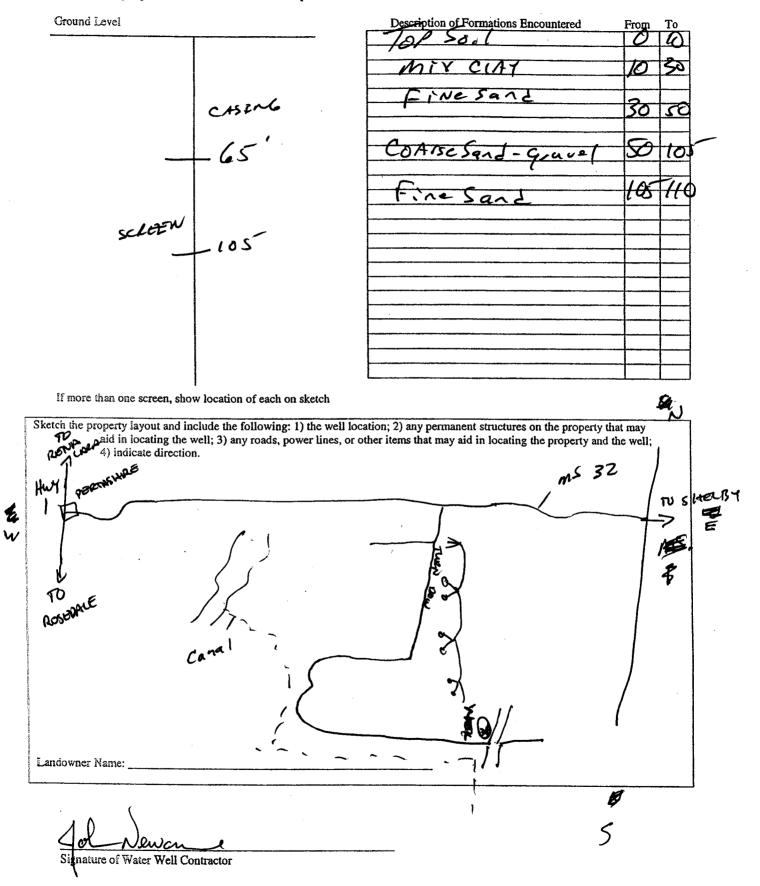

	STATE W	ELL REPORT		
County: <u>Botivar</u> Permit #: <u>6(1)</u> 43817	Part 2 Pump Installer's Completion Report Mississippi Department of Environmental Quality Office of Lánd and Water Resources P.O. Box 10631 Jackson, MS 39289-0631 (601)961-5210 (601)354-6938 (fax)		For Office Use Only: Aquifer:	
Driller J. Newcome 0.773				
Date completed: <u>6-8-15</u>				
This report should be prepared by th	e pump installer in deta	ail and filed with the Departme	ent within 30 days of the	
installation of pump. Well Owner Informat	ion	We	Il Location	
Owner Name: HE + SF Prope	Latitude: 33°553		57 Longitude: 090 51	
Mailing Address: Po'Boy C	me	Method of Lat/Long (circle o	ne): Conventional Survey,	
		USGS quad, Han	d-held GPS) Survey-grade GP	
City State	31202 Zip Code	NE 14 SW 14 Sec_ 1	8_Twn24W_Rng6U	
v		Distance Direction	Nearest Town	
Telephone No. ()		$\underline{\bigcirc}$ Miles $\underline{\frown}$	of Shelly	
Pump Type		7		
Circle one			ower Type Eircle one	
Air Lift Jet	Submersible	Diesel Engine Gasoli	ine Engine Natural G	
Bucket Piston	Turbine	Electric Motor Hand	Tractor P	
Centrifugal Rotary	Flowing Well	Windmill Other	(specify):	
Other (specify):		Horse Power Rating of Moto	\frown	
Date Pump Installed: 6/8/10		Setting Depth: 70 fort		
Rated Pump Capacity: 2500	Gallons Per Minute	Number of Stages:		
		<u> </u>		
Pump Test Data			easuring Water Level	
Date Well Tested:		Air Line Electric Me	asuring Line Steel Tape	
Static Water Level (A):Fee	· · ··································			
Pumping Water Level (B):Feet				
Drawdown [(B) - (A)]:Fee	t Below Land Surface	For flowing well, measured	shut in head:f	
Test Pumping Rate:	_Gallons Per Minute	Well yielded	GPM with a drawdown of	
Duration of Pump Test (minimum 4 hours)	:bours	feet after	hours of pump	
I HEREBY CERTIFY that the above states	ments are true to the best	of my knowledge.	Zun	
Print Name of Putup Installer and License	\smile \cdot \cdot \cdot	Signature of Pump	Installer	
			#785.00 (L. 1989	

RECEIVED AUG 0 2 2010 BY: OLMP