

# STATE WELL REPORT

## Part I

### Driller's Log

Mississippi Department of Environmental Quality  
Office of Land and Water Resources  
P.O. Box 2309  
Jackson, MS 39225-2309  
(601)961-5210  
(601)360-0535 (fax)

**For Office Use Only:**

Well #: D212  
Aquifer: \_\_\_\_\_  
E-Log #: \_\_\_\_\_

County: BOLIVAR  
Permit #: BW-50178  
Driller: Chad Mattox  
Date drilling completed: 10/3/17

*State Law requires that this report be prepared by the license holder responsible for the work and filed with the Department at the above address within 30 days of completion of drilling of the well or borehole.*

Well Owner Information <small>(Landowner if borehole is not for a water well)</small>	Well or Borehole Location
Owner Name: <u>RIVES NEBLETT</u>	Latitude: <u>33 57 35 N</u> Longitude: <u>90 46 15 W</u>
Mailing Address: <u>PO Box 26</u>	Method of Lat/Long (check one): Conventional Survey _____
<u>Shelby</u> <u>MS</u> <u>38774</u>	USGS quad _____, Hand-held GPS <input checked="" type="checkbox"/> , Survey-grade GPS _____
City State Zip Code	<u>NW</u> $\frac{1}{4}$ <u>SE</u> $\frac{1}{4}$ , Sec <u>01</u> $\checkmark$ T <u>24N</u> $\checkmark$ R <u>06W</u> $\checkmark$
Telephone No. (____) _____	<u>3/4</u> Miles <u>NW</u> of <u>Shelby</u>
	(Distance) (Direction) (Nearest Town)


Well / Borehole Data	
Date drilling started: <u>10/3/17</u>	Date drilling completed: <u>10/3/17</u> Hole depth: <u>125'</u> Hole diameter: <u>24"</u>
Location of the source of any surface water used for drilling: <u>NEARBY DITCH</u>	
Method of dosing and volume of Chlorine used in drilling and development: _____	
Logs run (circle all applicable): <u>No log run</u> Electric Gamma Ray Density Sonic Neutron Other: _____	
Name of organization running log(s): _____	
Purpose of borehole (circle one): <u>Water Well</u> Geotechnical/Geological Investigation Ground Source Heat Pump Seismic Survey Other (describe) _____	
<i>If drilling is not related to water well construction, skip the remainder of this block</i>	
Purpose of Well (circle all applicable): Home Industrial Public Supply <u>Irrigation</u> Fish Culture	
Other (describe): _____	
If a flowing well, method of flow regulation: Valve _____ Other (describe) _____	
Static Water Level: <u>22</u> feet <del>(above)</del> <u>(below)</u> land surface Date measured: <u>10/3/17</u> <small>(circle one)</small>	
Method of measurement (circle one): <u>Steel tape</u> Electric tape Air line Other (describe): _____	
Well depth: <u>125'</u> Well grouted to a depth of: <u>10</u> feet Type of grout (circle one): Neat Cement <u>Bentonite</u> Mix	
Casing length: <u>85</u> feet Casing diameter: <u>16</u> inches Type of casing: <u>PVC</u>	
Screen length: <u>40</u> feet Screen diameter: <u>16</u> inches Type of screen: <u>PVC</u>	
Screen slot size: <u>.050</u> inches Setting depth: From <u>60 85</u> feet to <u>125</u> feet	
Type of completion (circle all applicable): <u>Gravel packed</u> Underreamed Open hole Natural Development	
Other (describe): _____	
Top of lap pipe or reduction in casing: _____ feet	
<i>If telescoped or more than one screen, describe on next page</i>	

**RECEIVED**  
**NOV 03 2017**  
Form: OLWR-SWR-1A (4/13)  
**BY OLWR**

County: BOLIVAR  
Permit #: GW-50178

For Office Use Only:  
Well #: D212

*The sketch below only required for water wells  
If well telescopes, show depths on sketch.*

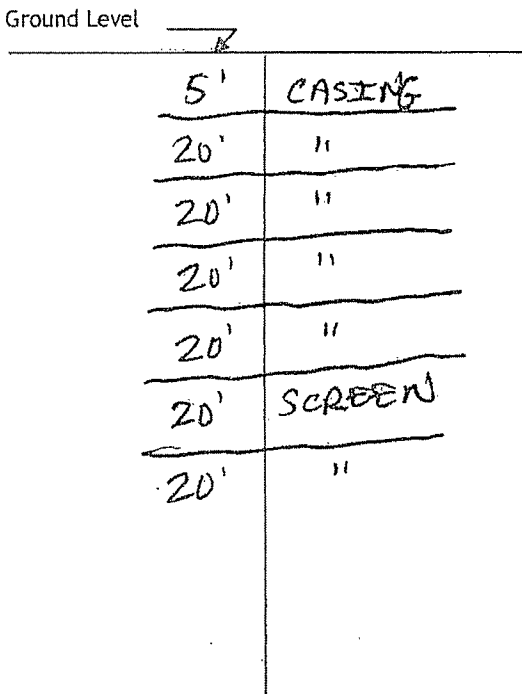

*Description of formations encountered must be provided for all wells and boreholes, unless specifically exempted by regulations*

Description of Formations Encountered	From (depth)	To (depth)
TOP SOIL	Ground level	18
FINE SAND + CLAY	18	38
FINE SAND	38	72
COURSE SAND	72	78
MED SAND + PEA GRAVEL	78	125

If more than one screen, show location of each on sketch

- Sketch the property layout and include the following:
- 1) the well location
  - 2) any permanent structures on the property that may aid in locating the well
  - 3) any roads, power lines, or other items that may aid in locating the property and the well
  - 4) north arrow

RECEIVED  
NOV 03 2017  
BY OLWR

Landowner Name: \_\_\_\_\_

I HEREBY CERTIFY that the well/borehole was drilled, constructed, and completed in accordance with all applicable requirements of the Mississippi Department of Environmental Quality and the Mississippi Department of Health regulations, if applicable, and state laws.

Chad H. Mattox LMR-8243 11/2/17 Chad H. Mattox  
Print Name of Responsible Licensee and License No. Date Signature of Licensee

# STATE WELL REPORT

## Part 2

**Pump Installer's Completion Report**  
 Mississippi Department of Environmental Quality  
 Office of Land and Water Resources  
 P.O. Box 2309  
 Jackson, MS 39225-2309  
 (601)961-5210  
 (601) 360-0535 (fax)

**For Office Use Only:**

Well #: D212  
 Aquifer: \_\_\_\_\_

County: BOLIVAR  
 Permit #: GW-50178 /  
 Driller: CHAD MATTOX  
 Date completed: 10-3-17  
 Copy information from block on Part 1

*This part of the report must be completed by a licensed water well contractor or a licensed pump installer. A copy of Part 1 of the report must be attached and both parts filed with the Department at the above address within 30 days of well completion.*

Well Owner Information	Well Location
Owner Name: <u>RIVES NEBLETT</u>	Latitude: <u>33° 57.35"</u> Longitude: <u>90° 46.15"</u>
Mailing Address: <u>P.O. BOX 26</u>	Method of Lat/Long (check one): Conventional Survey _____, USGS quad _____, Hand-held GPS _____, Survey-grade GPS _____
<u>SHELBY</u> <u>MS</u> <u>38974</u>	<u>NW 1/4</u> <u>SE 1/4</u> , Sec <u>01</u> - T <u>24 N</u> R <u>06 W</u>
City State Zip Code	<u>3/4</u> Miles <u>NW</u> of <u>SHELBY</u>
Telephone No. <u>(662) 398-5121</u>	(Distance) (Direction) (Nearest Town)

**Pump Type (circle one)**

Submersible  Turbine Air Lift Centrifugal Flowing Well Jet Piston Rotary Other (describe): \_\_\_\_\_

Date Pump Installed: 11-15-17 Rated Pump Capacity: 3000 Gallons Per Minute

Is This Pump (circle one):  New Repaired Replacement

**Power Type (circle one)**

Electric Diesel Gasoline Natural Gas Tractor PTO Windmill Other (describe): \_\_\_\_\_

Horse Power Rating of Motor: 60 Setting Depth: 70 feet Number of Stages: 1

**Pump Test Data for Non Flowing Well**

Date Well Tested: \_\_\_\_\_ Duration of Pump Test (minimum 4 hours): \_\_\_\_\_ hours

Static Water Level (A): 22 Feet Below Land Surface Pumping Water Level (B): \_\_\_\_\_ Feet Below Land Surface

Drawdown [(B) - (A)]: \_\_\_\_\_ Feet Below Land Surface Test Pumping Rate: \_\_\_\_\_ Gallons Per Minute

Method of measurement (circle one): Steel tape Electric tape Air line Other (describe): \_\_\_\_\_

**Pump Test Data for Flowing Well**

Measured shut in head: \_\_\_\_\_ feet.

Well yielded \_\_\_\_\_ GPM with a drawdown of \_\_\_\_\_ feet after \_\_\_\_\_ hours of pumping

**Meter Installation**

Meter Manufacturer: \_\_\_\_\_ Meter Serial Number: \_\_\_\_\_

Meter Model Number/Name: \_\_\_\_\_ Type of Meter: \_\_\_\_\_


Totalizer Register Unit and Multiplier Factor (AF x .001, gal x 1000, etc): \_\_\_\_\_

Installation Date: \_\_\_\_\_ Meter installed by: \_\_\_\_\_

Is This Meter (circle one): New Repaired Replacement

*Important: By submitting the above information you are certifying that this meter was installed to manufacturer standards. For agricultural wells, a list of approved meters is on the MDEQ website.*

I HEREBY CERTIFY that the above statements are true to the best of my knowledge.

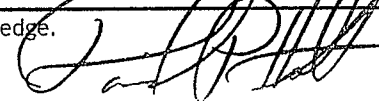DAVID P. HOLT 0-752P 12-11-17 

Print Name of Pump Installer and License No. (if applicable) Date Signature of Pump Installer

RECEIVED  
 DEC 15 2017  
 BY OLWR

17-0768