

BOLIVAR
E-24

MISSISSIPPI BOARD OF WATER COMMISSIONERS

4-2-59 WATER WELL DRILLERS LOG

11/5/65
CODED

Date: April 2, 1959, Driller: Layne-Central Company County Bolivar
(Name)

(1) Owner of Land: <u>A.M. Wooten & Company</u> (Name)	Description & Color of Materials Sand, Clay, Red Clay, Shell, etc.	Thick- ness Feet	Depth Feet
<u>Shelby, Mississippi</u> (Address)	<u>Clay</u>	<u>12</u>	<u>12</u>
(2) Location: <u>1/4, 1/4, Sec 27, T2R5</u> <u>5 miles east</u> of <u>Shelby</u> (distance) (direction) (Nearest Town)	<u>Hard packed sand, coarse</u>	<u>30</u>	<u>42</u>
(3) Topography: <u>flat</u> (Hilly) (Flat) (Level)	<u>Coarse sand</u>	<u>35</u>	<u>77</u>
(4) Purpose of Well: <u>irrigation</u> (Domestic Irrigation Municipal, Industrial, Other)	<u>Coarse sand & lignite</u>	<u>7</u>	<u>84</u>
	<u>Gravel</u>	<u>15</u>	<u>99</u>
	<u>Big gravel & boulders</u>	<u>9</u>	<u>108</u>

Information upon completion of well:


- (1) Diameter 18x16 inches.
- (2) Total Depth 108 feet.
- (3) Water Level 23' feet below top of ground.
- (4) Cased to 56' Size 18"
2" 16"
- (5) Screen: Size 16", Length 50'
- (6) Were any formations sealed against pollution?
no yes, no no.

CODED

If YES depth of formation _____

Why _____

Drillers Remarks: _____

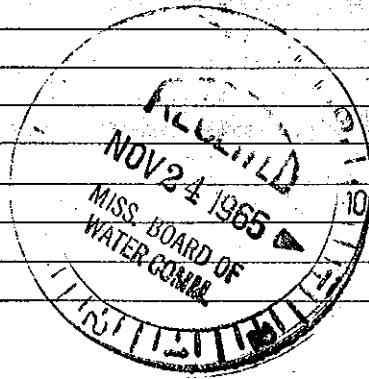

(Use Back Side)

Well No.

Mail this copy to Board of Water Commissioners 429 Miss. St. Jackson, Miss.