

**BOLIVAR** MISSISSIPPI BOARD OF WATER COMMISSIONERS

**CODED**

**E-33**

**WATER WELL DRILLERS LOG**

8-9-61

Date: Aug 9, 1961; Driller: Robert E. Ratliff Co. Bolivar County Bolivar

(Name)

| (1) Owner of Land: <u>Bolivar Co. Baptist Seminary</u><br>(Name) | Description & Color of Materials<br>Sand, Clay, Red Clay, Shell, etc. | Thick-<br>ness<br>Feet | Depth<br>Feet |
|--|---|------------------------|---------------|
| <u>Mound Bayou, Miss</u><br>(Address)                            | <u>gumbo, sand</u>  | <u>0</u>               | <u>23</u>     |
|  | <u>sand</u>   | <u>23</u>              | <u>46</u>     |
| (2) Location: <u>1/4, 1/4, Sec 32 T4RS,</u>                      | <u>white sand</u>   | <u>46</u>              | <u>419</u>    |
| <u>1</u> miles <u>North</u> , of <u>Mound Bayou</u>              | <u>sand, shale</u>  | <u>419</u>             | <u>480</u>    |
| (distance) (direction) (Nearest Town)                            | <u>shale</u>  | <u>480</u>             | <u>605</u>    |
| (3) Topography: <u>↓</u>   | <u>rock</u>   | <u>605</u>             | <u>605</u>    |
| (Hilly) (Flat) (Level)   | <u>shale rock</u>   | <u>606</u>             | <u>615</u>    |
| (4) Purpose of Well: <u>domestic</u>                             | <u>gumbo</u>  | <u>615</u>             | <u>705</u>    |
| (Domestic Irrigation Municipal, Industrial, Other)               | <u>gumbo, sand</u>  | <u>703</u>             | <u>724</u>    |
|  | <u>sand</u>   | <u>724</u>             | <u>745</u>    |
|  | <u>gumbo</u>  | <u>754</u>             | <u>896</u>    |

Information upon completion of well:


- (1) Diameter 2x4 inches.
- (2) Total Depth 754 feet.
- (3) Water Level Flowing feet below top of ground.
- (4) Cased to 754', Size 2"
- (5) Screen: Size 2", Length 20'
- (6) Were any formations sealed against pollution?  
 yes,  no.

If YES depth of formation cased

Why

Drillers Remarks:

**CODED**

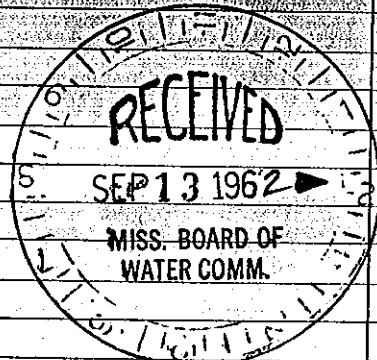

Well No.

(Use Back Side)

Mail this copy to Board of Water Commissioners 429 Miss. St. Jackson, Miss.