

BOLIVAR MISSISSIPPI BOARD OF WATER COMMISSIONERS

E-X 37

1-22-66

WATER WELL DRILLERS LOG

BITANE GAS CO

Date: 1/22, 1966, Driller: OF GREENWOOD County LEFLORE

(Name)

CODED

(1) Owner of Land: A.W. SANDERS
(Name)

MOHAND BAYON, MISS
(Address) 29 5
56

(2) Location: 1/4, Sec. T R

3 miles (distance) (direction) MOHAND BAYON (Nearest Town)

(3) Topography: FLAT
(Hilly) (Flat) (Level)


(4) Purpose of Well: IRRIGATION
(Domestic Irrigation, Municipal, Industrial, Other)

Description & Sand, Clay, Red Clay, Shale, etc.	Thick-ness Feet	Depth Feet
0-12 Gumbo	12	12
23 BLUE CLAY	11	23
34 FINE SAND	11	34
42 CLAY + FINE SAND	8	42
55 SAND + PEA GRAVEL	13	55
85 GRAVEL	30	85
94 SAND + GRAVEL	9	94
105 GRAVEL	11	105

BOTTOM OF WELL
102 FEET

Information upon completion of well:

- (1) Diameter 16 inches.
- (2) Total Depth 102 feet.
- (3) Water level feet below top of ground.
- (4) Cased to 62" Size 16"
- (5) Screen: Size 16", Length 40 FT.
- (6) Were any formations sealed against pollution?
yes, no.

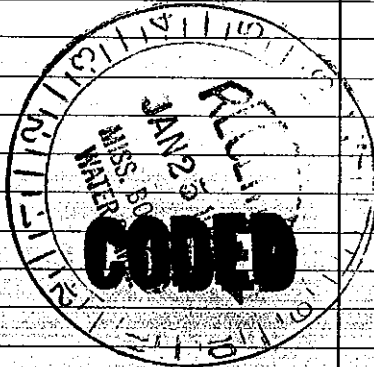

If YES depth of formation

Why

Drillers Remarks:

id in G. P. M.: 2650

power: DIESEL

as irrigated & Acreage: RICE, COTTON BEANS

(Use Back Side)

Well No.

Mail this copy to Board of Water Commissioners 429 Miss. St. Jackson, Miss.