

Bolivar MISSISSIPPI BOARD OF WATER COMMISSIONERS

E-38

3-66

WATER WELL DRILLERS LOG


Date: 3-1-1966, Driller: Five County Farm **CODED** Bolivar
(Name)

| (1) Owner of Land: <u>Henny & Henny</u> (Name) | Description & Color of Materials Sand, Clay, Red Clay, Shell, etc. | Thick- ness Feet | Depth Feet |
|--|---|------------------------|---------------|
| <u>Shelby Miss</u> (Address) | <u>0-27' Clay</u> | | <u>27</u> |
| (2) Location: <u>1/4, 1/4, Sec. 23 T24 R5</u> | <u>fine sand & gravel</u> | <u>46 1/2</u> | <u>46 1/2</u> |
| <u>1/4</u> miles <u>East</u> of <u>Shelby</u> (distance) (direction) (Nearest Town) | <u>fine sand - gravel</u> | | <u>59 1/2</u> |
| (3) Topography: <u>Flat</u> (Hilly) (Flat) (Level) | <u>trace of clay & charcoal,</u> | | <u>66</u> |
| (4) Purpose of Well: <u>Rice irrigation</u> (Domestic Irrigation Municipal, Industrial, Other) | <u>Rock & Sand</u> | | <u>72' 6"</u> |
| | <u>fine sand</u> | | |
| | <u>coarse sand hats</u> | | <u>114</u> |
| | <u>of Rock & gravel</u> | | |
| | <u>Clay</u> | | <u>131</u> |

Information upon completion of well:

- (1) Diameter 16 inches.
- (2) Total Depth 114 feet.
- (3) Water Level 28 1/2 feet below top of ground.
- (4) Cased to 66, Size 16
- (5) Screen: Size 16, Length 48
- (6) Were any formations sealed against pollution?
no

CODED

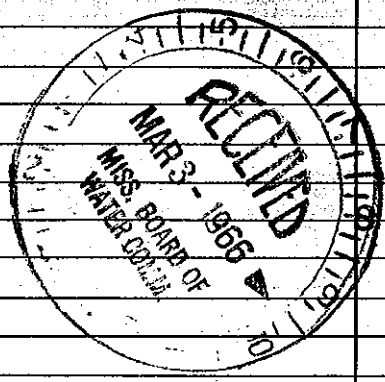

If YES depth of formation _____
Why _____
Drillers Remarks: 4 1/2' gravel
formation all available
at this depth.

Well No.

(Use Back Side)

Mail this copy to Board of Water Commissioners 429 Miss. St. Jackson, Miss.