

BOLIVAR MISSISSIPPI BOARD OF WATER COMMISSIONERS

E 46 ~~59~~

CODED

WATER WELL DRILLERS LOG

7-10-63

Date: 7/10, 1963, Driller: Dick W. D. Supply Co. County: Bolivar
(Name)

| (1) Owner of Land | Description & Color of Materials Sand, Clay, Red Clay, Shell, etc. | Thick- ness Feet | Depth Feet |
|--|---|------------------------|---------------|
| Maryland Plantations (Name) Shelby (Address) | Sand clay | 32 | 32 |
| (2) Location: 1/4, 1/4, Sec. 4 T24N5W | Fine Hard sand | 50 | 82 |
| 3 miles East of Shelby (distance) (direction) (Nearest Town) | Coarse Sand | 11 | 93 |
| (3) Topography: Flat (Hilly) (Flat) (Level) | 11 x Signal | 12 | 105 |
| (4) Purpose of Well: Irrigation (Domestic Irrigation, Municipal, Industrial, Other) | Blue clay | | |

CODED


Information upon completion of well:

- (1) Diameter 16 inches.
- (2) Total Depth 105 feet.
- (3) Water Level 31 feet below top of ground.
- (4) Cased to _____, Size _____.
- (5) Screen: Size 16", Length 40 ft.
- (6) Were any formations sealed against pollution?
_____ yes, _____ no.

If YES depth of formation _____

Why _____

Drillers Remarks: _____

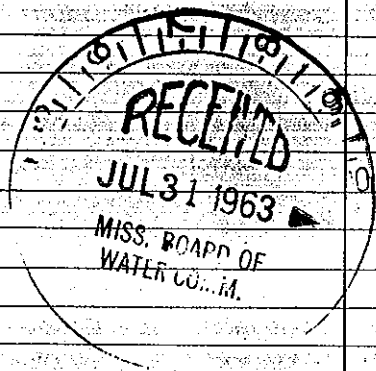

Well No.

(Use Back Side)

Mail this copy to Board of Water Commissioners 429 Miss. St. Jackson, Miss.