

BOLIVAR
E 55

MISSISSIPPI BOARD OF WATER COMMISSIONERS

11/30/65
C659

5-4-59 GROUNDWATER WELL DRILLERS LOG

CODED

Date: May 4, 1959, Driller: Layne-Central Company County Bolivar
(Name)

	Description & Color of Materials Sand, Clay, Red Clay, Shell, etc.	Thick- ness Feet	Depth Feet
(1) Owner of Land: Charles C. Heinsz & C.E. Heinsz & (Name)			
Shelby, Mississippi (Address)	Clay	20	20
(2) Location: T24N Sec. 6 T. R. 5W	Fine sand	20	40
_____ miles north of Shelby (distance) (direction) (Nearest Town)	Coarse sand	12	52
(3) Topography: flat (Hilly) (Flat) (Level)	Coarse sand & pea gravel	33	85
(4) Purpose of Well: irrigation (Domestic Irrigation Municipal, Industrial, Other)	Sand, gravel, big gravel	27	112

Information upon completion of well:

(1) Diameter **12** inches.

(2) Total Depth **112** feet.

(3) Water Level **20' 3"** feet below top of ground.

(4) Cased to **62'**, Size **12"**

(5) Screen: Size **12"**, Length **50'**


(6) Were any formations sealed against pollution?
_____ yes, **no** no.

CODED

If YES depth of formation _____

Why _____

Drillers Remarks:
1613 GPM.
Electric power.

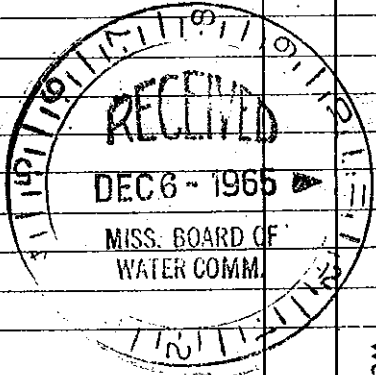

Well No.

(Use Back Side)

Mail this copy to Board of Water Commissioners 429 Miss. St. Jackson, Miss