

BOLIVAR MISSISSIPPI BOARD OF WATER COMMISSIONERS

E 56 CODED WATER WELL DRILLERS LOG  
6-5-62

6/10/62  
CODED  
C132

Date: June 5, 1962, Driller: Layne-Central Company County Bolivar

(Name)

		Description & Color of Materials Sand, Clay, Red Clay, Shell, etc.	Thick- ness Feet	Depth Feet
(1) Owner of Land: <u>Heinsz C.E. and Charles C.</u> (Name) <u>Shelby, Mississippi</u> (Address)		Clay	12	12
(2) Location: <u>T21N, R5W</u> <u>1/4, 1/4, Sec. 1</u> <u>1 miles east of Shelby</u> (distance) (direction) (Nearest Town)		Fine sand	12	24
(3) Topography: <u>flat</u> (Hilly) (Flat) (Level)		Fine black sand	11	35
(4) Purpose of Well: <u>irrigation</u> (Domestic Irrigation Municipal, Industrial, Other)		Coarse sand	19	54
		Coarse sand, pea gravel	5	59
		Coarse sand, gravel	36	95
		Boulders	8	103
		Clay		103


Information upon completion of well:

- (1) Diameter 16 inches.
- (2) Total Depth 103 feet.
- (3) Water Level 26' 4" feet below top of ground.
- (4) Cased to 53', Size 16"
- (5) Screen: Size 16", Length 50'
- (6) Were any formations sealed against pollution?  
no yes, no no.

If YES depth of formation \_\_\_\_\_

Why \_\_\_\_\_

Drillers Remarks: \_\_\_\_\_

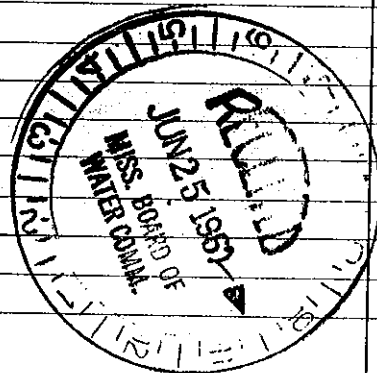

(Use Back Side)

Well No. \_\_\_\_\_

Mail this copy to Board of Water Commissioners 429 Miss. St. Jackson, Miss