

**BOLIVAR MISSISSIPPI BOARD OF WATER COMMISSIONERS**

E-~~57~~  
4-20-63

**WATER WELL DRILLERS LOG**

CODED

Date: 4/20, 1963, Driller: Deltarwell Supply Co. County Bolivar  
(Name)

	Description & Color of Materials Sand, Clay, Red Clay, Shell, etc.	Thick- ness Feet	Depth Feet
(1) Owner of Land: <u>W. J. Chudy</u> (Name) <u>Cleveland</u> (Address)	Bush shot	19	
	Reddish sand	10	29
	Fine gray sand		
(2) Location: $\frac{1}{4}$ , $\frac{1}{4}$ , Sec. <u>6</u> T <u>24</u> R <u>5</u> N <u>2</u> miles <u>North</u> of <u>Shelby</u> (distance) (direction) (Nearest Town)	With clay	42	71
	Coarse sand & gravel	30	101
(3) Topography: <u>Flat</u> (Hilly) (Flat) (Level)	Coarse sand & gravel	7	108
(4) Purpose of Well: <u>Irrigation</u> (Domestic Irrigation, Municipal, Industrial, Other)	Bottom on blue clay		

Information upon completion of well:


- (1) Diameter 16 inches.
- (2) Total Depth 108 feet.
- (3) Water Level 22 feet below top of ground.
- (4) Cased to \_\_\_\_\_, Size \_\_\_\_\_.
- (5) Screen: Size 16, Length 40.
- (6) Were any formations sealed against pollution?  
\_\_\_\_\_ yes,  no.

If YES depth of formation \_\_\_\_\_

Why \_\_\_\_\_

Drillers Remarks: \_\_\_\_\_

CODED

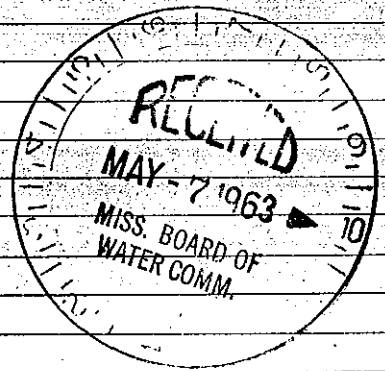

(Use Back Side)

Well No.

Mail this copy to Board of Water Commissioners 429 Miss. St. Jackson, Miss