

BOLIVAR
E59
3-30-75

MISSISSIPPI
 BOARD OF WATER COMMISSIONERS
 416 North State Street
 Jackson, Mississippi 39201

WATER WELL DRILLERS LOG

CODED

3/30 1975 *Dallas Well Supply Co* Bolivar
 date well completed firm name county well located

LANDOWNER:
Maryland Plantation
P.O. Shelby Miss.
 (mailing address)

description of formations encountered	from	to
<i>Top soil</i>	<i>0</i>	<i>23</i>
<i>Thin Blue sand</i>	<i>23</i>	<i>45</i>
<i>" sand</i>	<i>45</i>	<i>70</i>
<i>sand & gravel</i>	<i>70</i>	<i>107</i>

WELL LOCATION:
 sec 1 T 24 N R 5 E
5 1/2 miles *east* of *Shelby*
 (distance) (direction) (nearest town)

WELL PURPOSE: *Irrigation*
 (home, irrigation, municipal, industrial)

WELL COMPLETION DATA:

(1) diameter (inches) 16

(2) total depth (feet) 107

(3) static water level (feet) 22 below above top of ground.

(4) casing Steel
 (material) (depth)
 (size) If telescope see back.


(5) screen 40
 (length) (depth to top)
16 steel
 (size) (material)

(6) pump 57 2200
 (HP) (yield gpm)
elec
 (type power)

(7) electric log No
 (yes or no)
 (organization running log)

(8) how well bottom plugged Steel Plate

CODED

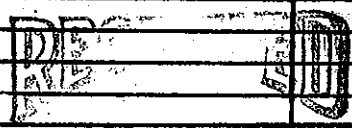

APR - 8 1975

DRILLERS REMARKS: