

CODED

CODED

Bolivar
E 63
6-67

MISSISSIPPI
BOARD OF WATER COMMISSIONERS
416 North State Street
Jackson, Mississippi 39201

WATER WELL DRILLERS LOG

6/8 1967 Dallas Well Supply Co Bolivar
date well completed firm name county well located

LANDOWNER:
James L. Nason
RFD Cleveland
(mailing address)

description of formations encountered	from	to
Clay		6
dry sand	13	19
Coarse sand	19	35
Fine "	25	45
Coarse "	45	100
Fine "	100	108
Sand + gravel	108	123

WELL LOCATION:
sec. 31 T 24 N R 5 E
W
2 miles West Throusbury
(distance) (direction) (nearest town)

WELL PURPOSE: Irrigation
(home, irrigation, municipal, industrial)

WELL COMPLETION DATA:

(1) diameter (inches) 12

(2) total depth (feet) 123

(3) static water level (feet) 19 below above top of ground.

(4) casing steel 85
(material) (depth)
(size) If telescope see back.


(5) screen 38 85
(length) (depth to top)
12 steel
(size) (material)

(6) pump Tractor 1800
(HP) (yield gpm)
Tractor
(type power)

(7) electric log yes or no
(organization running log)

(8) how well bottom plugged

CODED

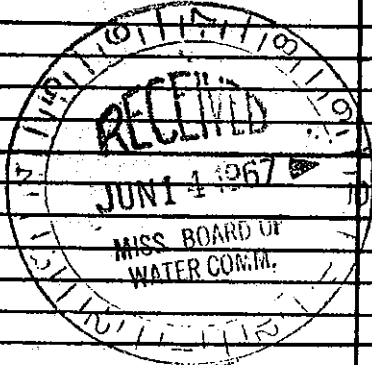

DRILLERS REMARKS: